


FILED  
GREENVILLE CO. S. C.

FEB 2 9 36 AM '81

DONNIE S. TANKERSLEY  
R.M.C.

GREENVILLE CO SCHOOL DIST.  
PROPERTY.

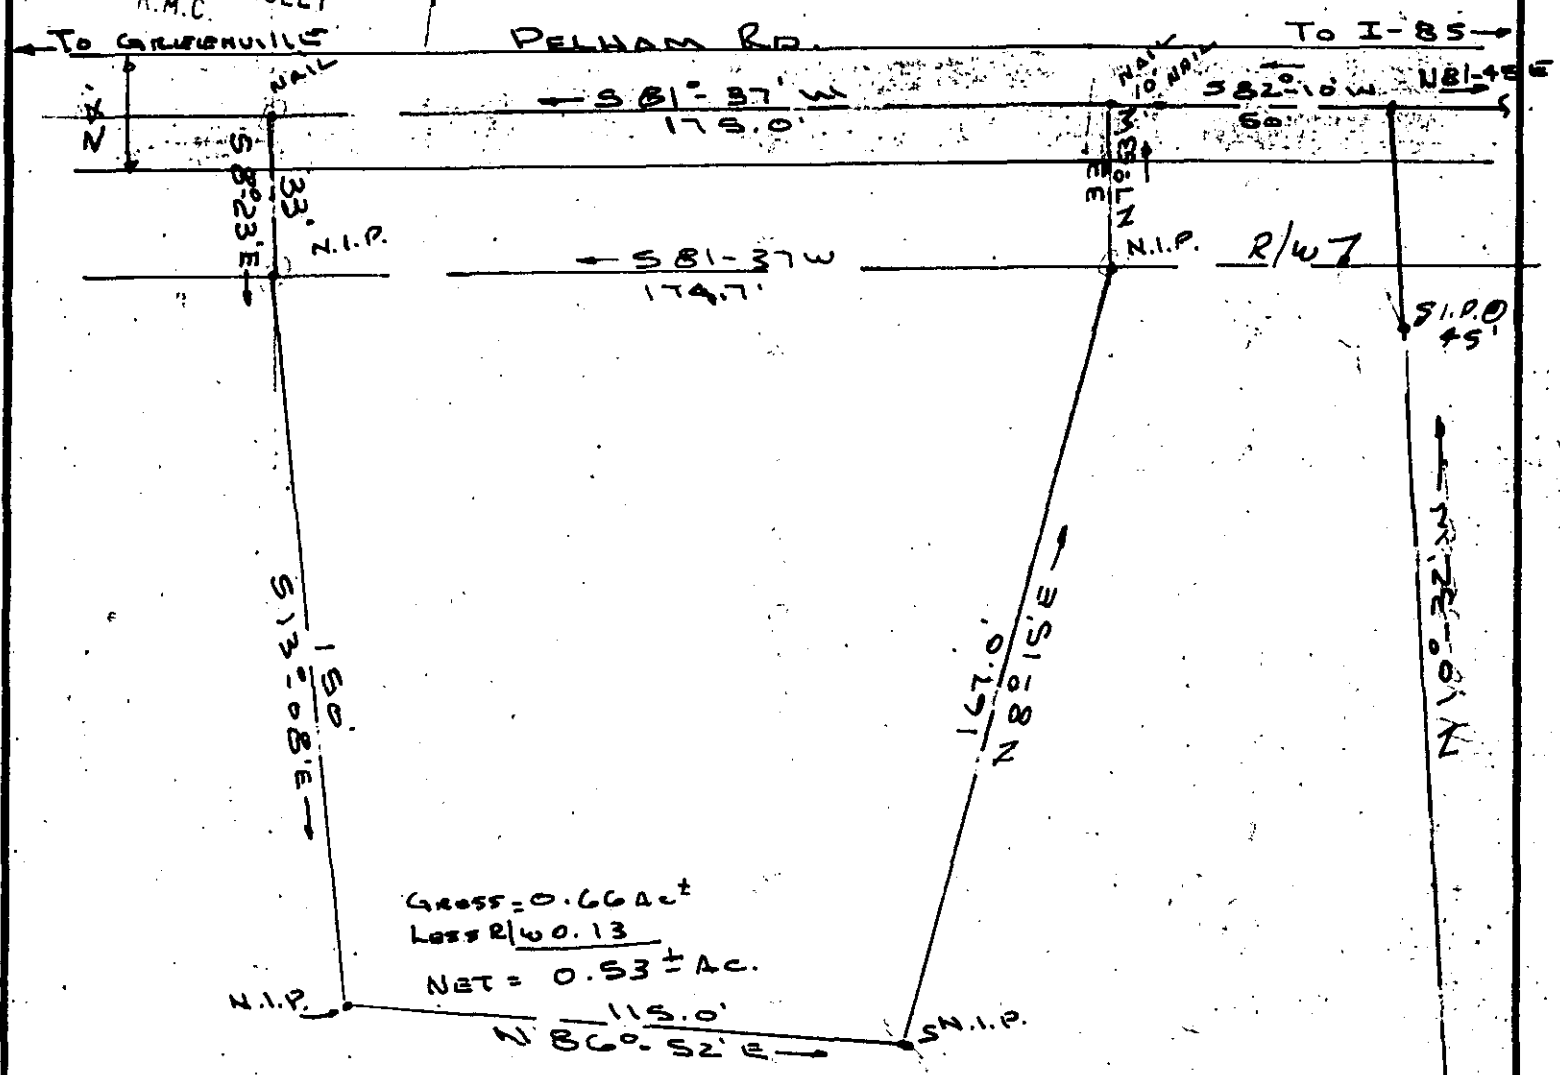


LOIS D. JONES  
(6)

I CERTIFY THE ABOVE TRACT HAS  
BEEN SURVEYED AND CUT FROM THE  
TRACT OF LOIS D. JONES AND IS  
AS SHOWN TO THE BEST OF  
MY KNOWLEDGE.


REF. BLK BK SW. 540.1-1-6  
PLT. BK. "X" PG. 99-A" 2/11/50

✓ J.L. 33

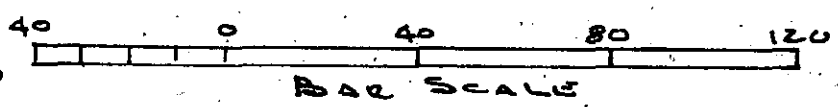

FEB 2 1981 21991

*Kenneth J. Gould*  
S.C. REG. NO 4035

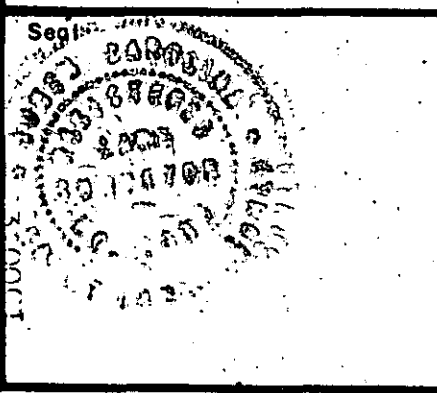

PROPERTY OF  
RUSSELL M. POORE &  
ANN J. POORE

1204 PELHAM RD.  
GREENVILLE, S.C.

Gould & Assoc.  
SURVEYORS

TAYLORS, S.C.

Drawn By K.T.G.

Checked By

Scale 1" = 40'

Date 1-28-81

File No.

Dwg. No.