

FILED
GREENVILLE CO. S.C.
MAR 2 1 14 PM '81
DONNIE S. TANKERSLEY
R.M.C.

This is to certify that on February 24, 1981, I surveyed the property shown on this plat, known as Lot 6 on plat of Edwards Forest, recorded in the GMC Office of Greenville County in Plat Book EE on page 105, and that the property lines, walls and buildings are as shown hereon; that the building located on said lot does not encroach or project on adjacent streets or property, and that no adjacent walls or buildings encroach or project on said premises, and that no utility lines cross this property except as shown hereon. This house is not located in a designated flood hazard area.

James R. Freeland
James R. Freeland RLS & PE 4781


MAR 2 1981

24584

8-L-99



SCTO --- 1 MR 281 1266
P&H ENGINEERING

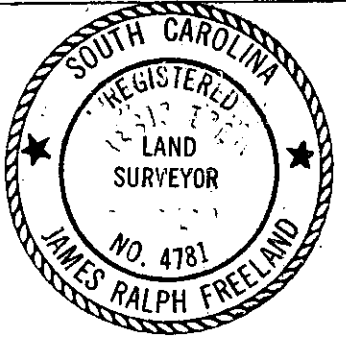

SEAL

**STATE OF SOUTH CAROLINA
GREENVILLE COUNTY**

EDWARDS FOREST
LOT 6
PROPERTY OF
JOHN FREDRICK AUSTERMANN
FRANCES OPAL AUSTERMANN

FREELAND & ASSOCIATES
Engineers • Land Surveyors
GREENVILLE, S.C.

SURVEY JRF & BH III
DRAWN BR
CHECK MLC
SCALE 1" = 40'
DATE FEB. 24. 81
DWG. NO. 6193