AF 10505

MICROFILMED

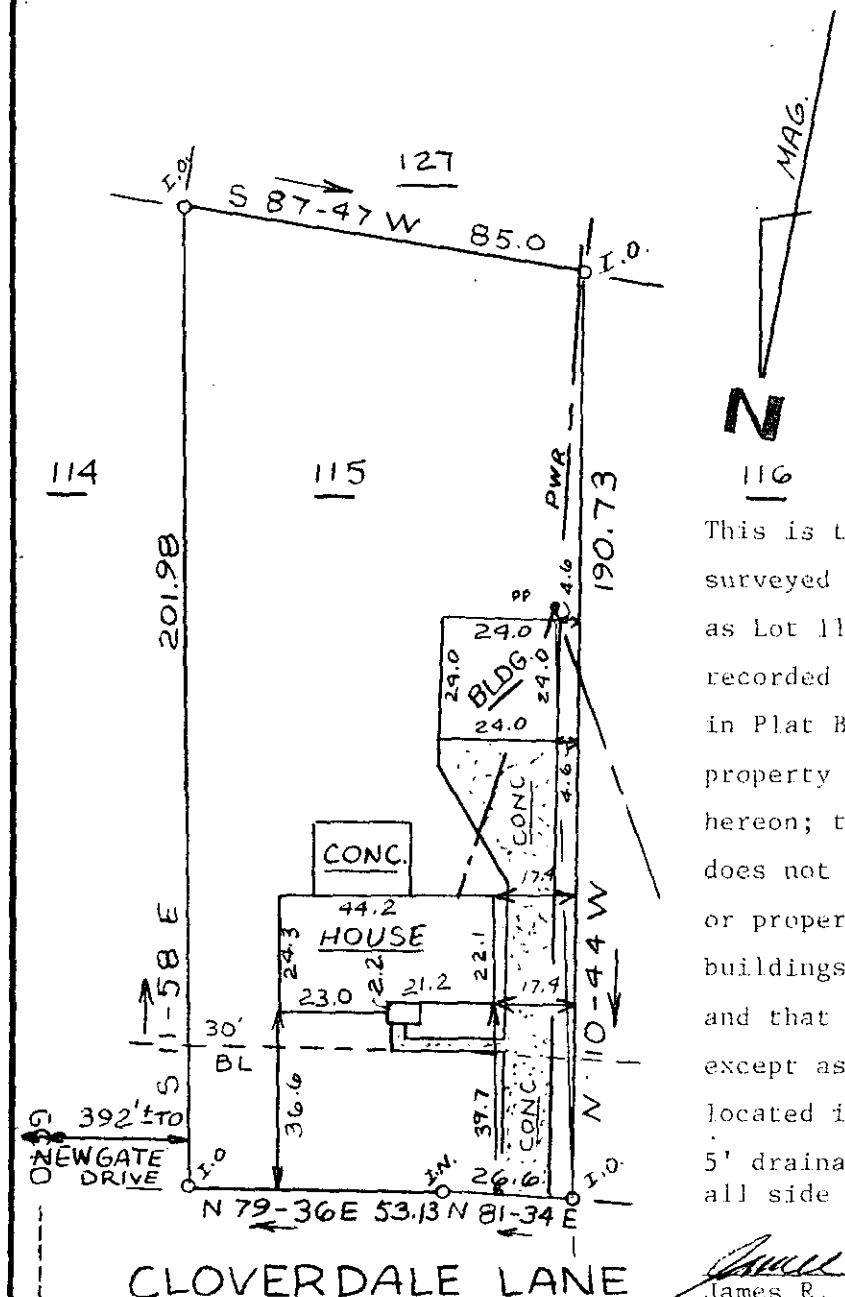

This is to certify that on March 12, 1981, I surveyed the property shown on this plat, known as Lot 115 on plat of Bellingham Sec. 2, recorded in the RMC Office of Greenville County in Plat Book 4N on page 79, and that the property lines, walls and buildings are as shown hereon; that the building located on said lot does not encroach or project on adjacent streets or property, and that no adjacent walls or buildings encroach or project on said premises, and that no utility lines cross this property except as shown hereon. This property is not located in a designated flood hazard area.

5' drainage and utility easement each side of all side and rear lot lines.

James R. Freeland RLS & PE 4781

FILED
GREENVILLE CO. S.C.
MAR 16 3 18 PM '81
DONNIE S. TANKERSLEY
R.M.C.

25869

8-M-25

MAR 16 1981

3 MR16 81

300.1-1-95

080

001

PRINT MACHINE INC.

SOUTH CAROLINA REGISTERED LAND SURVEYOR NO. 4781 JAMES RALPH FREELAND

SEAL

STATE OF SOUTH CAROLINA
GREENVILLE COUNTY

BELLINGHAM
SEC. 2 - LOT 115
PROPERTY OF
DONALD E. PARK
NORMA D. PARK

FREELAND & ASSOCIATES
Engineers • Land Surveyors
GREENVILLE, S.C.

SURVEY	LT
DRAWN	RES
CHECK	MLC
SCALE	1" = 40
DATE	3-12-81
DWG. NO.	6261