
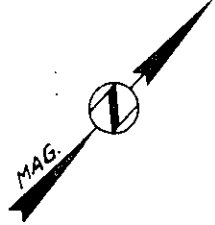


MICROFILMED

Reviewed and Approved: *Timothy H. Jan*
Asst. Surveyor


FILED
 GREENVILLE CO. S.C.
 APR 6 12 51 PM '81
 DONNIE STRAKERSLEY
 R.M.C.

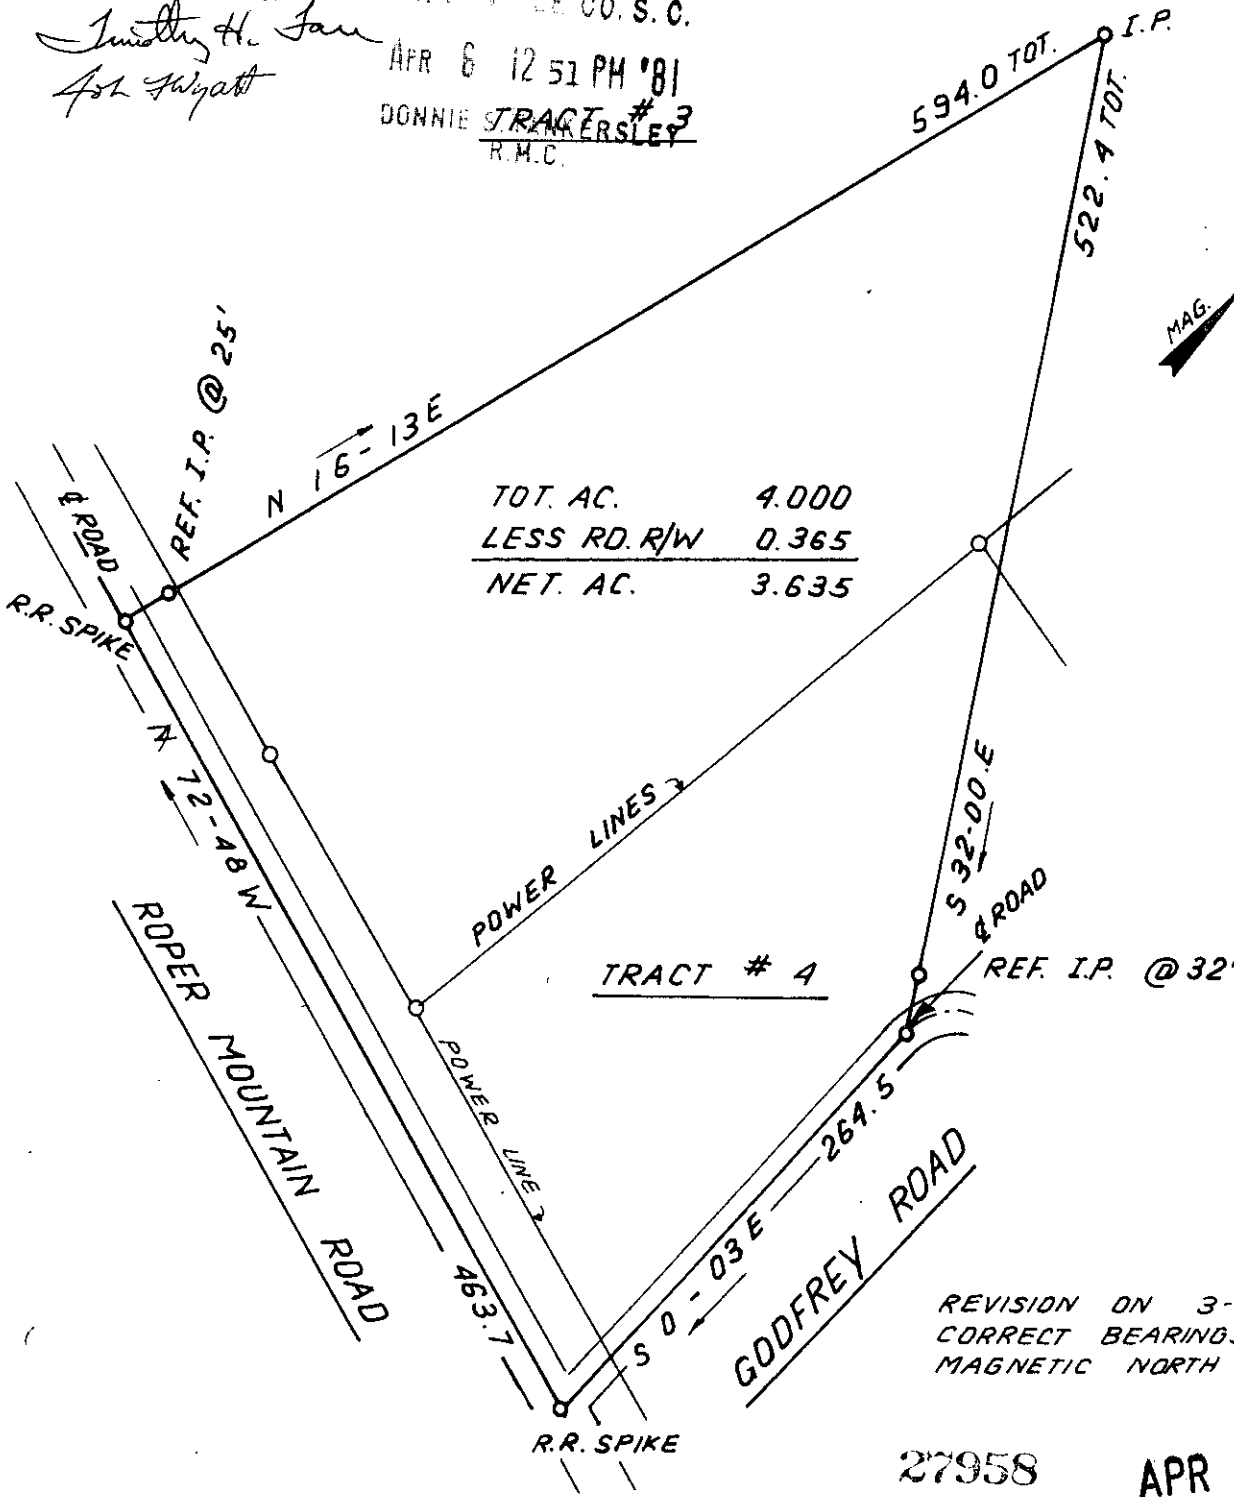

REVISION ON 3-27-81
 CORRECT BEARINGS TO
 MAGNETIC NORTH

27958

APR 6 1981

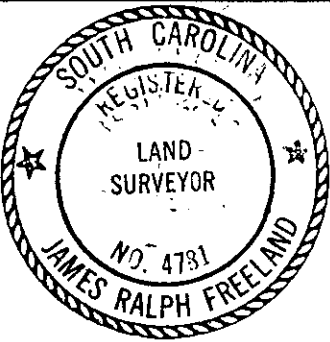

STATE OF SOUTH CAROLINA
 GREENVILLE COUNTY

FREELAND & ASSOCIATES
 Engineers • Land Surveyors

GREENVILLE, S.C.

TRACT # 4

LOYD A. SMITH LIFE ESTATE

JM-68

SURVEY	F.L.
DRAWN	B.R.
CHECK	F.L.
SCALE	1" = 100'
DATE	OCT. 24.79
DWG. NO.	79-4226-C

300 8 141801

SEAL