



MICROFILMED

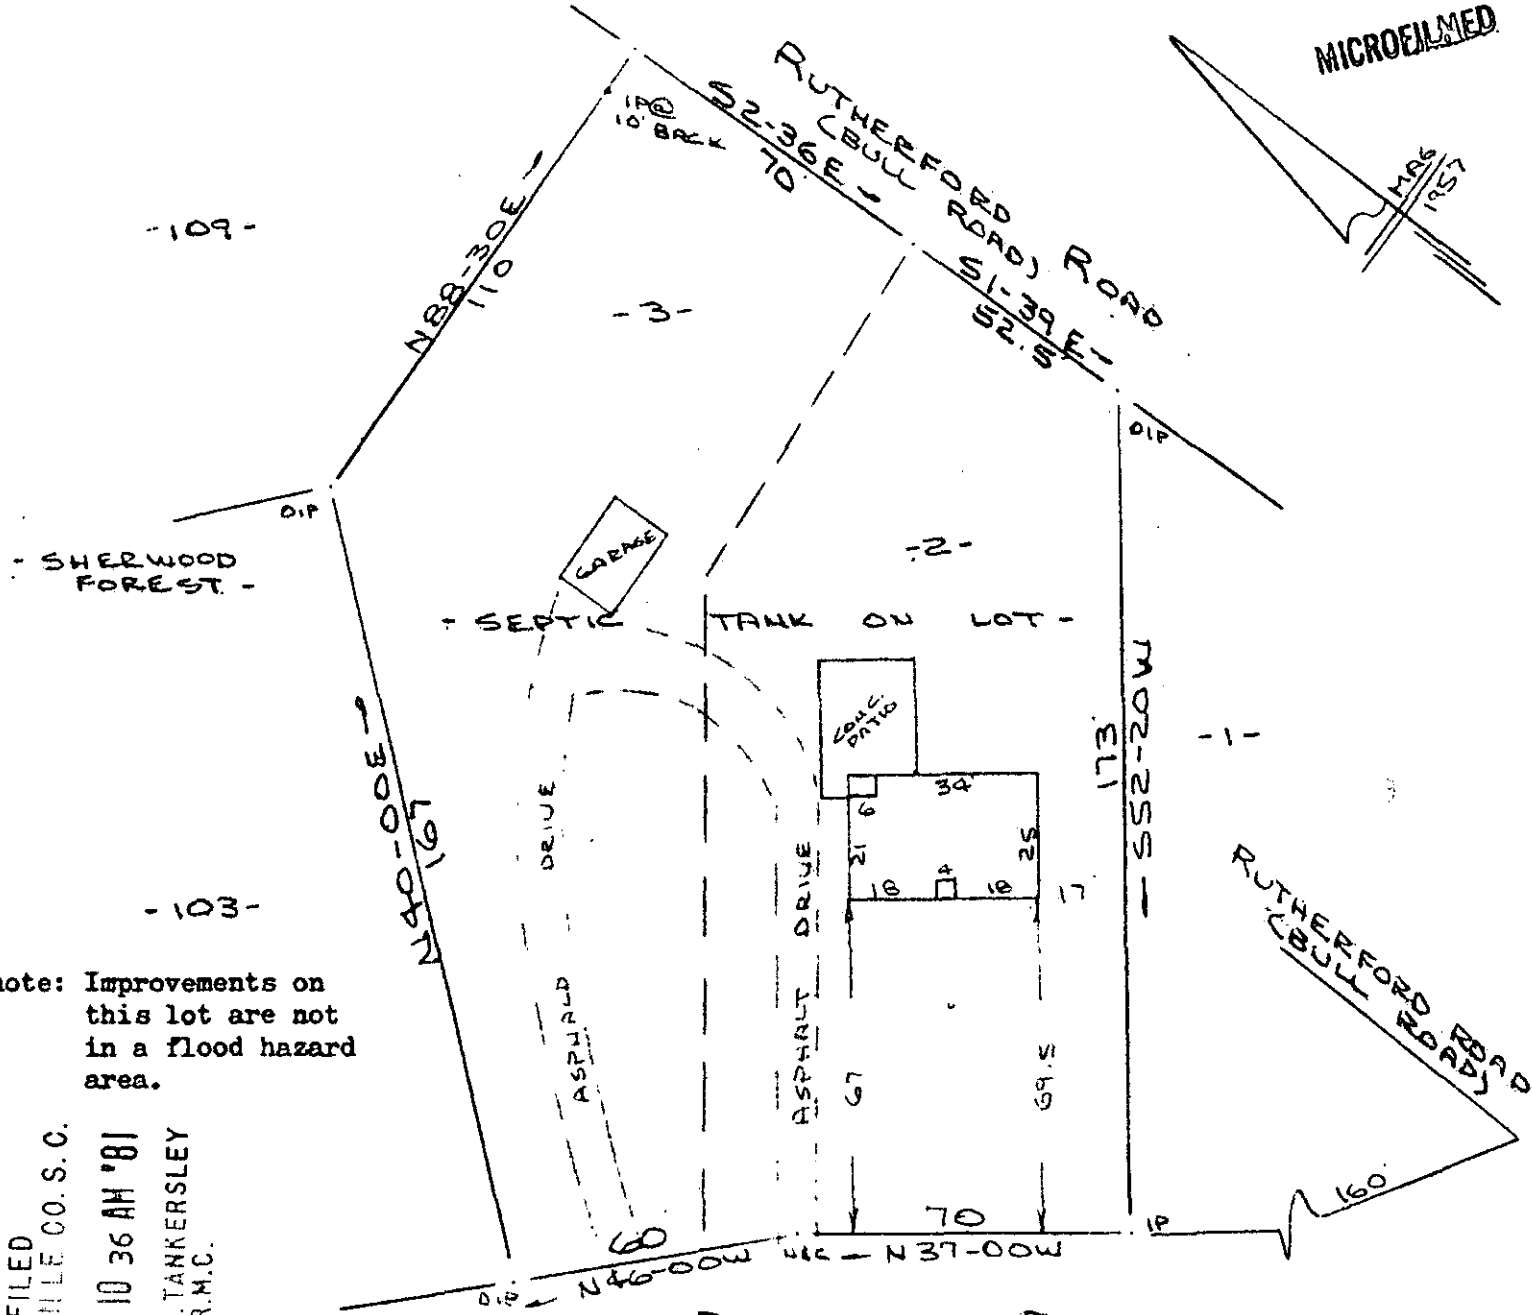

note: Improvements on this lot are not in a flood hazard area.

FILED
GREENVILLE CO. S. C.
APR 13 10 36 AM '81
DONNIE S. TANKERSLEY
R.M.C.

PROPERTY OF
WILLIAM DREYER SAUDER & EUNICE H. SAUDER
GREENVILLE COUNTY, S. C.
SCALE: 1"=40' 10 APR 1981

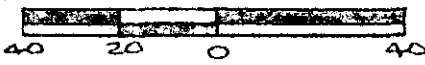

This is to certify that on the 10th day of April, 1981, I surveyed the property shown on this plat, being known as lots 2 & 3 on plat of PROPERTY OF H. S. HAYNES and recorded in the REC Office Greenville County, S. C., in Plat Book "00" at Page 80; and that the property lines, walls and buildings are as shown hereon, and that the walls and buildings located on said lot do not encroach or project on adjacent street or property, and that no adjacent walls or buildings encroach or project on said premises, and no power lines cross this property except as shown hereon.

APR 10 1981

R. B. Bruce

R. B. Bruce, RLS 1952

CAROLINA SURVEYING CO.
112 Manly St., Greenville, S. C.

300 B 2011801

8-M-83