

FILED  
 GREENVILLE CO. S.C.  
 MAY 1 3 29 PM '81  
 DONNIE S. TANKERSLEY  
 R.M.C.


This is to certify that on April 28, 1981, I surveyed the property shown on this plat, known as Lot 273 on plat of Westwood Sec. 3, recorded in the RMC Office of Greenville County in Plat Book 4N on page 30, and that the property lines, walls and buildings are as shown hereon; that the building located on said lot does not encroach or project on adjacent streets or property, and that no adjacent walls or buildings encroach or project on said premises, and that no utility lines cross this property except as shown hereon. This property is not located in a designated flood hazard area.

5' drainage and utility easement along all side and rear lot lines.

*James R. Freeland*  
 James R. Freeland RLS & PE 4781

30653

8-0-44

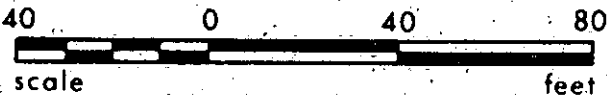

574.8-1-94



SEAL

**STATE OF SOUTH CAROLINA  
 GREENVILLE COUNTY**

WESTWOOD  
LOT 273, SEC. 3  
PROPERTY OF  
MARJORIE L. REID

**FREELAND & ASSOCIATES**  
 Engineers • Land Surveyors

GREENVILLE, S.C.

SURVEY I.T.  
 DRAWN B.P.  
 CHECK MC  
 SCALE 1" = 40'  
 DATE APRIL 28, 81  
 DWG. NO. 6422

SCTD --- 1 MY 181 1166

PRINT MACHINE INC.