


This is to certify that on the 15th day of December, 1980, I surveyed the property shown on this plat, being known as parts of lot 22 & 23 on plat of PROPERTY OF PATRICIA O. JENKINS and recorded in the RKC Office Greenville County, S. C., in Plat Book at Page ; and that the property lines, walls and buildings are as shown hereon, and that the walls and buildings located on said lot do not encroach or project on adjacent street or property, and that no adjacent walls or buildings encroach or project on said premises, and no power lines cross this property except as shown hereon.

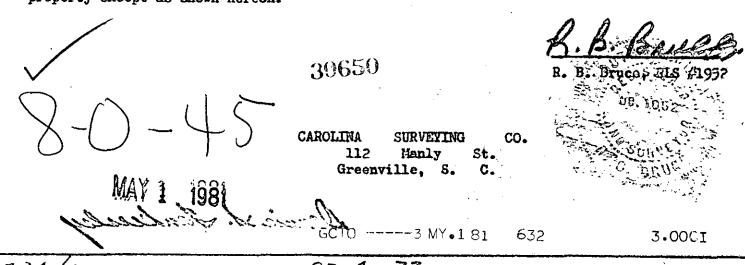

234/2

93-4-33