

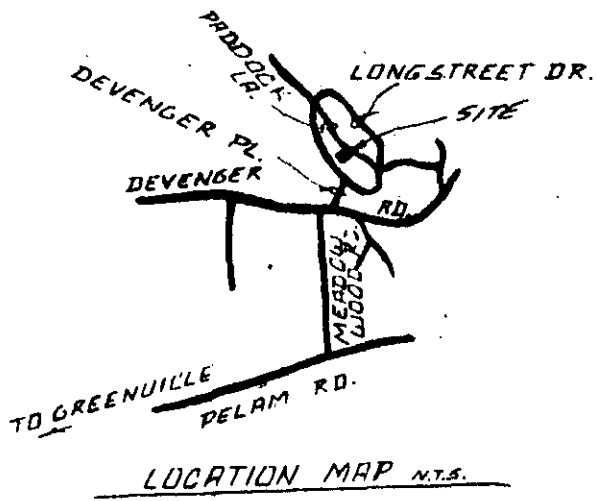


MICROFILMED

PLAT REF PLAT BOOK 4X, P. 79

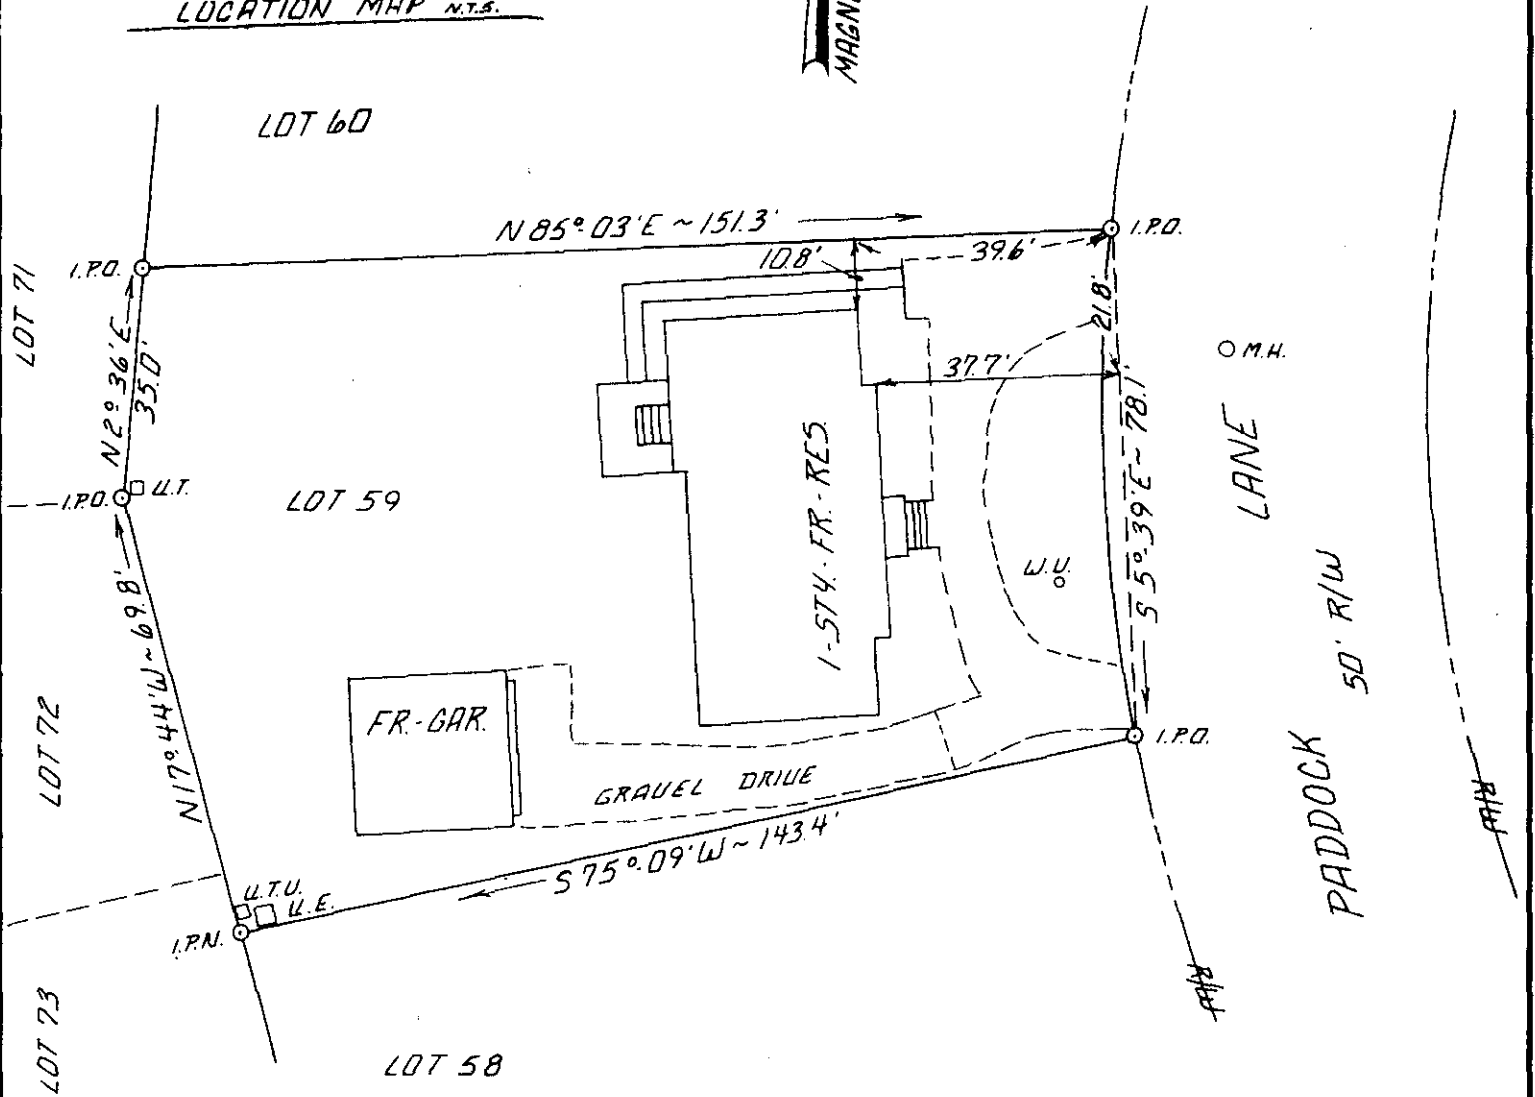

FILED
 GREENVILLE CO. S.C.
 MAY 4 2 59 PM '81
 DONNIE S. TANKERSLEY
 R.M.C.

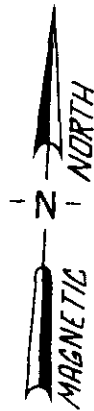

MAY 4 1981
 30818

✓ 8-0-48


PRINTED

APR 28 1981

ENWRIGHT
 SURVEYING, INC.

I HEREBY CERTIFY, THAT TO THE BEST OF MY KNOWLEDGE, THE MEASUREMENTS AS SHOWN ABOVE ARE CORRECT AND THERE ARE NO ENCROACHMENTS OR PROJECTIONS OTHER THAN SHOWN.

Thurl M. Amick 4032
 SURVEYOR'S SIGNATURE S.C. REG. NO.

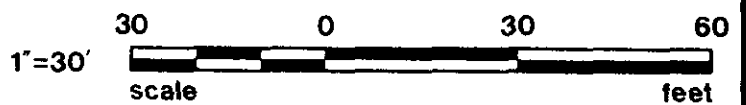

300 8

REV.	DATE	BY	DESCRIPTION	APP.

SURVEY FOR:
 STEPHEN F. & CARLA T. OSERNAK
 LOT 59-SEG. N01 DEVENGER PL.
 GREENVILLE CO. S.C.

enwright associates, inc.
 engineers, planners, surveyors
 GREENVILLE, SOUTH CAROLINA

DATE	SCALE	DWG. NO.
4/28/81	1"=30'	B1221-00-1-00