MICROFILMED

FILED
GREENVILLE CO. S. C.
MAY 8 1 48 PM '81
DONNIE S. TANKERSLEY
R.M.C.

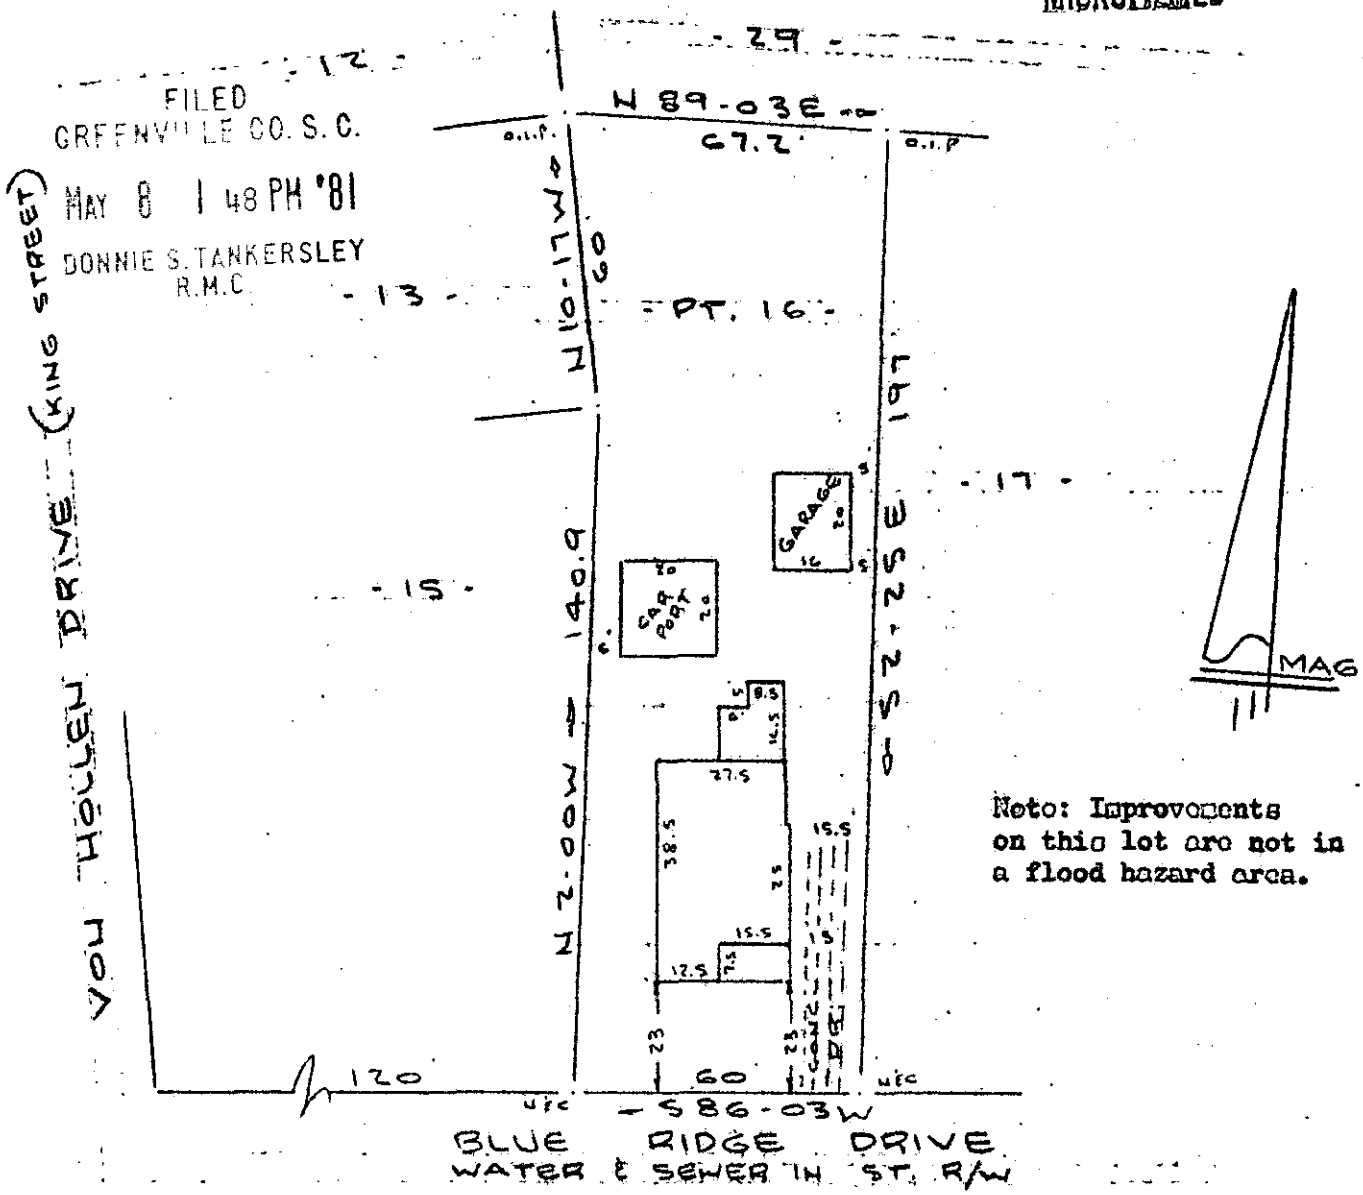

Note: Improvements on this lot are not in a flood hazard area.

PROPERTY OF
RONALD L. ASHTON & JANE L. ASHTON
GREENVILLE COUNTY, S. C.
SCALE: 1" = 40' 7 MAY 1981

This is to certify that on the 7th day of May, 1981, I surveyed the property shown on this plat, being known as part of lot 16 on plat of REVISED PLAT PROPERTY OF ETHEL Y. PERRY ESTATE and recorded in the RMC Office Greenville County, S. C., in Plat Book " K " at Page 303; and that the property lines, walls and buildings are as shown hereon, and that the walls and buildings located on said lot do not encroach or project on adjacent street or property, and that no adjacent walls or buildings encroach or project on said premises, and no power lines cross this property except as shown hereon. Also being known as PROPERTY OF RONALD L. ASHTON & JANE L. ASHTON and recorded in Plat Book at Page

8-0-59 31301

R. B. Bruce, RLS #1952

CAROLINA SURVEYING CO.
112 Manly St.
Greenville, S. C.

MAY 8 1981

300-3-1-0-2-1-1-A-0-1

736/42-A 167-4-24