

FILED  
GREENVILLE CO. S. C.


MAY 13 11 19 AM '81

DONNIE S. TANKERSLEY  
R.M.C.


MICROFILMED

EAST NORTH ST.  
WATER IN ST R/W

Note: Improvements on  
this lot are not in a  
flood hazard area.

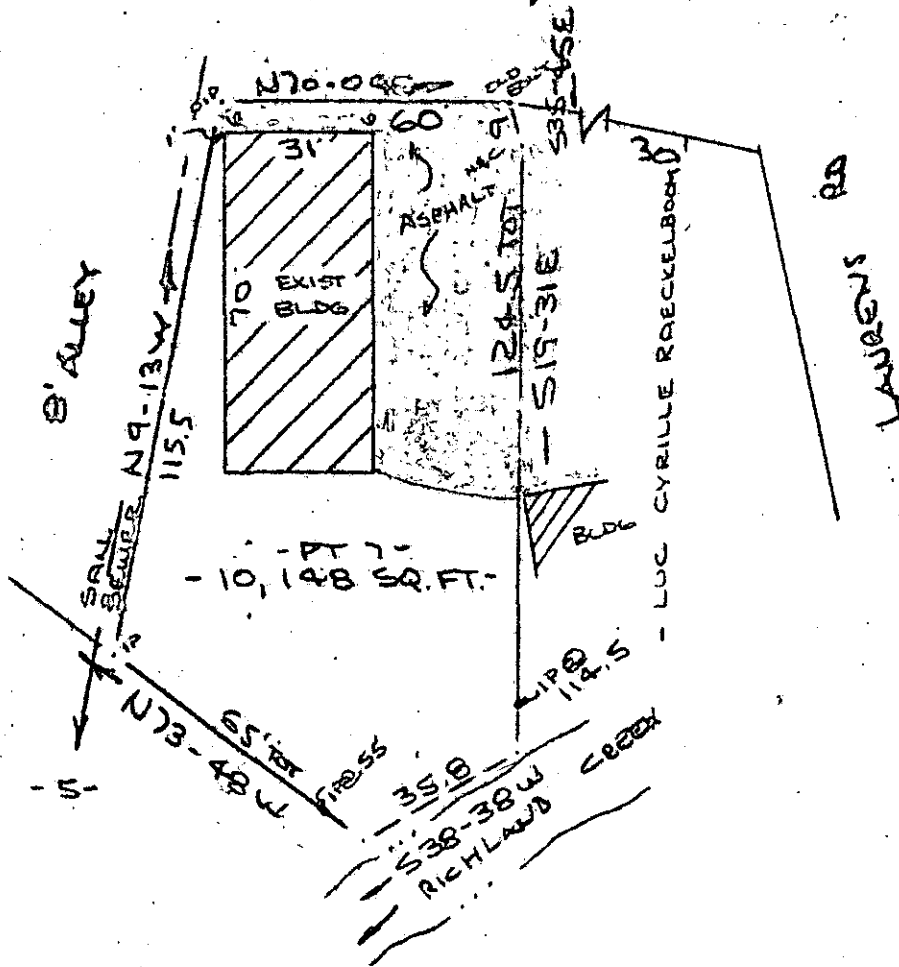

PROPERTY OF  
GARY J. JONES, LOUIS VALENTE & JOHN F. DE LEO, JR.  
GREENVILLE, S. C.  
SCALE: 1" = 40' MAY 11 1981

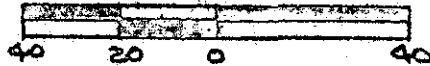

This is to certify that on the 11th day of May, 1981, I surveyed the property shown on this plat, being known as part of lot 7 an plat of H. H. GRIFFIN PROPERTY and recorded in the REC Office Greenville County, S. C., in Plat Book " F " at Page 165 and also being known as PROPERTY OF GARY J. JONES, LOUIS VALENTE & JOHN F. DeLEO, JR. and recorded in the Plat Book at Page ; and that the property lines, walls and buildings are as shown hereon, and that the walls and buildings located on said lot do not encroach or project on adjacent street or property, and that no adjacent walls or buildings encroach or project on said premises, and no power lines cross this property except as shown hereon.

8-0.75

31705

*R. B. Bruco*  
R. B. Bruco, RLS #1952

CAROLINA SURVEYING CO.  
112 Hanly St  
Greenville, S. C. 29615

342

3.00CI

13126

47-1-1

901