


COPELAND DRIVE

This is to certify that on May 11, 1981, I surveyed the property shown on this plat, known as Part Lot 7 on Plat of G.A. Copeland Estate, Plat #2, recorded in the RMC Office of Greenville County in Plat Book WW on Page 64, and that the property lines, walls and buildings are as shown hereon; that the building located on said lot does not encroach or project on adjacent streets or property, and that no adjacent walls or buildings encroach or project on said premises, and that no utility lines cross this property except as shown hereon. This property is not located in a designated flood hazard area.

MAY 13 1981

31706 *James R. Freeland*
 James R. Freeland RLS & PE 4781

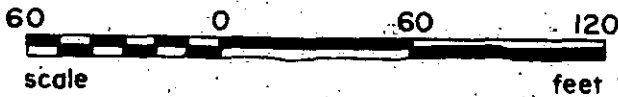

T. 9.2-1-13.2



**STATE OF SOUTH CAROLINA
 GREENVILLE COUNTY**

FREELAND & ASSOCIATES
 Engineers • Land Surveyors

GREENVILLE, S.C.

G. A. COPELAND ESTATE

PT. LOT 7

PROPERTY OF

G. EDWARD SULLIVAN

BEVERLY A. SULLIVAN

SURVEY JRF

DRAWN BR

CHECK *MLC*

SCALE 1" = 60'

DATE MAY 11, 81

DWG. NO. 6456

PRINT MACHINE #16511