

32816

8-R-1


FILED
 MAY 26 2 20 PM '81
 DONNIE S. TANKERSLEY
 R.M.C.

MAY 26 1981

This is to certify that on May 21, 1981, I surveyed the property shown on this plat, known as Lot 133 on plat of Pebblecreek Phase I, recorded in the RMC Office of Greenville County in Plat Book 5D on page 2, and that the property lines, walls and buildings are as shown hereon; that the building located on said lot does not encroach or project on adjacent streets or property, and that no adjacent walls or buildings encroach or project on said premises, and that no utility lines cross this property except as shown hereon. This property is not located in a designated flood hazard area.

5' drainage and utility easement
 each side of all side and rear
 lot line

James R. Freeland
 James R. Freeland RLS & PE 4781

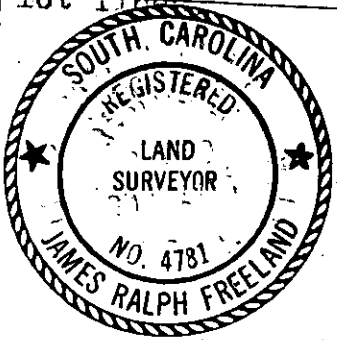

STATE OF SOUTH CAROLINA
 GREENVILLE COUNTY

PEBBLECREEK
 PHASE 1 LOT 133
 PROPERTY OF
 MORRIS F. HALL
 PATRICIA A. HALL

FREELAND & ASSOCIATES
 Engineers • Land Surveyors

GREENVILLE, S.C.

SURVEY	MLC
DRAWN	MLC
CHECK	MLC
SCALE	1" = 40'
DATE	5-21-81
DWG. NO.	81-6496