

MICROFILMED

ECHOLS STREET

PICKNEY STREET

MARGUERITE G. WHITMIRE - 21-1-76

ESTELLE BENNETT - 21-1-182

N 57 25 E

99'

HAROLD M. ALLISON - 21-1-201

Note: Improvements on this lot are not in a flood hazard area.

PROPERTY OF
FREDERICK D. SMITH AND MARY LOUISE G. SMITH
GREENVILLE S. CAROLINA
SCALE 1"=40' 22 MAY 1981




This is to certify that on the 22nd day of May, 1981, I surveyed the property shown on this plat, being known as PROPERTY OF FREDERICK D. SMITH & MARY LOUISE SMITH and recorded in the REC. Office Greenville County, S. C., in Plat Book at Page ; and that the property lines, walls and buildings are as shown hereon, and that the walls and buildings located on said lot do not encroach or project on adjacent street or property, and that no adjacent walls or buildings encroach or project on said premises, and no power lines cross this property except as shown hereon.

MAY 28 1981

8-R-6

33002

R. B. Bruce
R. B. Bruce, RLS 21952

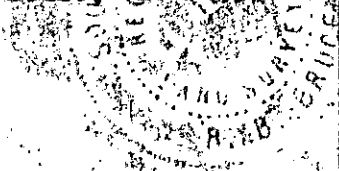

CAROLINA SURVEYING CO.
112 Hanly St.
Greenville, S. C.

FILED:
GREENVILLE CO. S. C.
MAY 20 11 13 AM '81
DONNIE S. TANKERSLEY
R.M.C.

300 3 15681A01