


Z MAGNETIC

FILED  
GREENVILLE CO. S.C.  
JUL 10 3 47 PM '81  
DONNIE S. TANKERSLEY  
R.M.C.

PRINCE, ET AL

EDWARDS

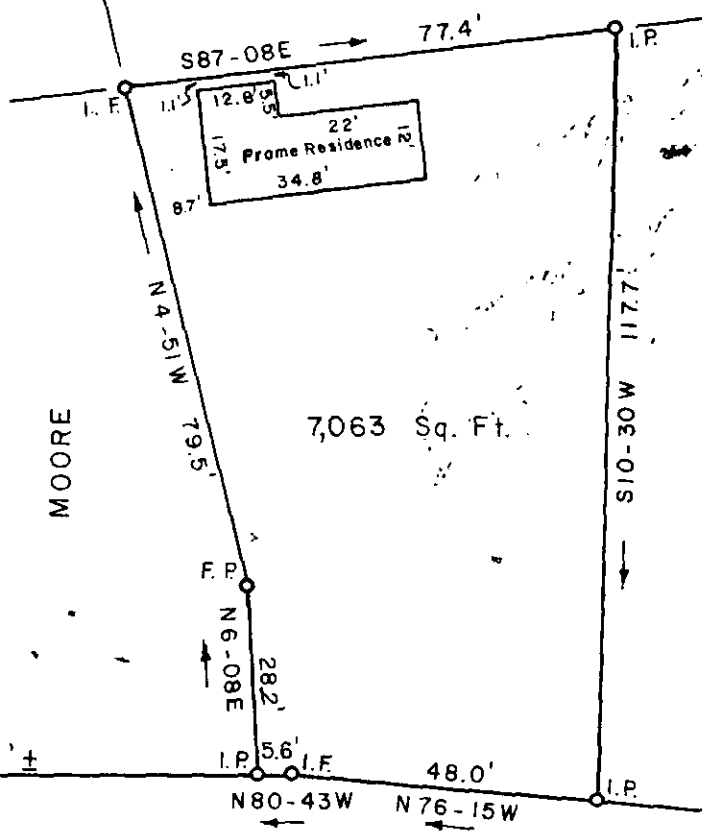

OLD BUNCOMBE ROAD

NEELY STREET

MOORE

BATSON

LEGEND

- I. F. — Iron Found
- I. P. — Iron Placed
- F. P. — Fence Post

*J-R-96*

JUL 10 1981


Reference:  
Deed Book 862, page 269.  
Plat Book F, page 98.

I HEREBY CERTIFY THAT THE RATIO OF PRECISION OF THE FIELD SURVEY IS 1/10,000 AS SHOWN HEREON AND THE AREA WAS DETERMINED BY DMD METHOD OF AREA CALCULATIONS.


PROPERTY OF  
**BETTY JEAN GIRARDEAU**  
GREENVILLE CO., S. C.

MAY 48 1981

SCALE 1" = 30'

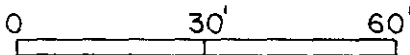

*David C. Kirk*  
DAVID C. KIRK SC.R.L.S. No. 6676  
EASLEY, S. C.

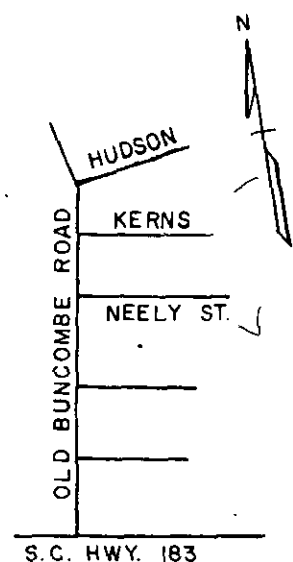

LOCATION MAP

*Michael J. ...*  
(FILE No. 81.5.1)