


This is to certify that on June 26, 1981, I surveyed the property shown on this plat, known as Lots 3, 4 & 5 on plat of Property of Louise Thruston and Mable Thruston Glazner, recorded in the RMC Office of Greenville County in Plat Book V on page 17, and that the property lines, walls and buildings are as shown hereon; that the building located on said lot does not encroach or project on adjacent streets or property, and that no adjacent walls or buildings encroach or project on said premises, and that no utility lines cross this property except as shown hereon. This property is not located in a designated flood hazard area.

James R. Freeland
 James R. Freeland RLS & PE 4781

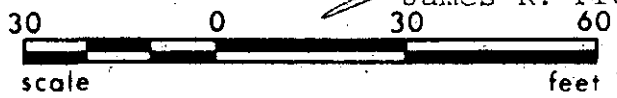

87-6-2.2 & 2.3



**STATE OF SOUTH CAROLINA
 GREENVILLE COUNTY**

PROP. OF LOUISE THRUSTON
MABLE THRUSTON GLAZNER
LOT 3, 4, & 5
PROPERTY OF
EDGAR B. HEAPE & SON, INC.

FREELAND & ASSOCIATES
 Engineers • Land Surveyors

GREENVILLE, S.C.

SURVEY	JRF
DRAWN	BR
CHECK	MLC
SCALE	1"=30'
DATE	JUNE 26, 81
DWG. NO.	6615

PRINT & BINDING INC. 00%