


MICROFILMED

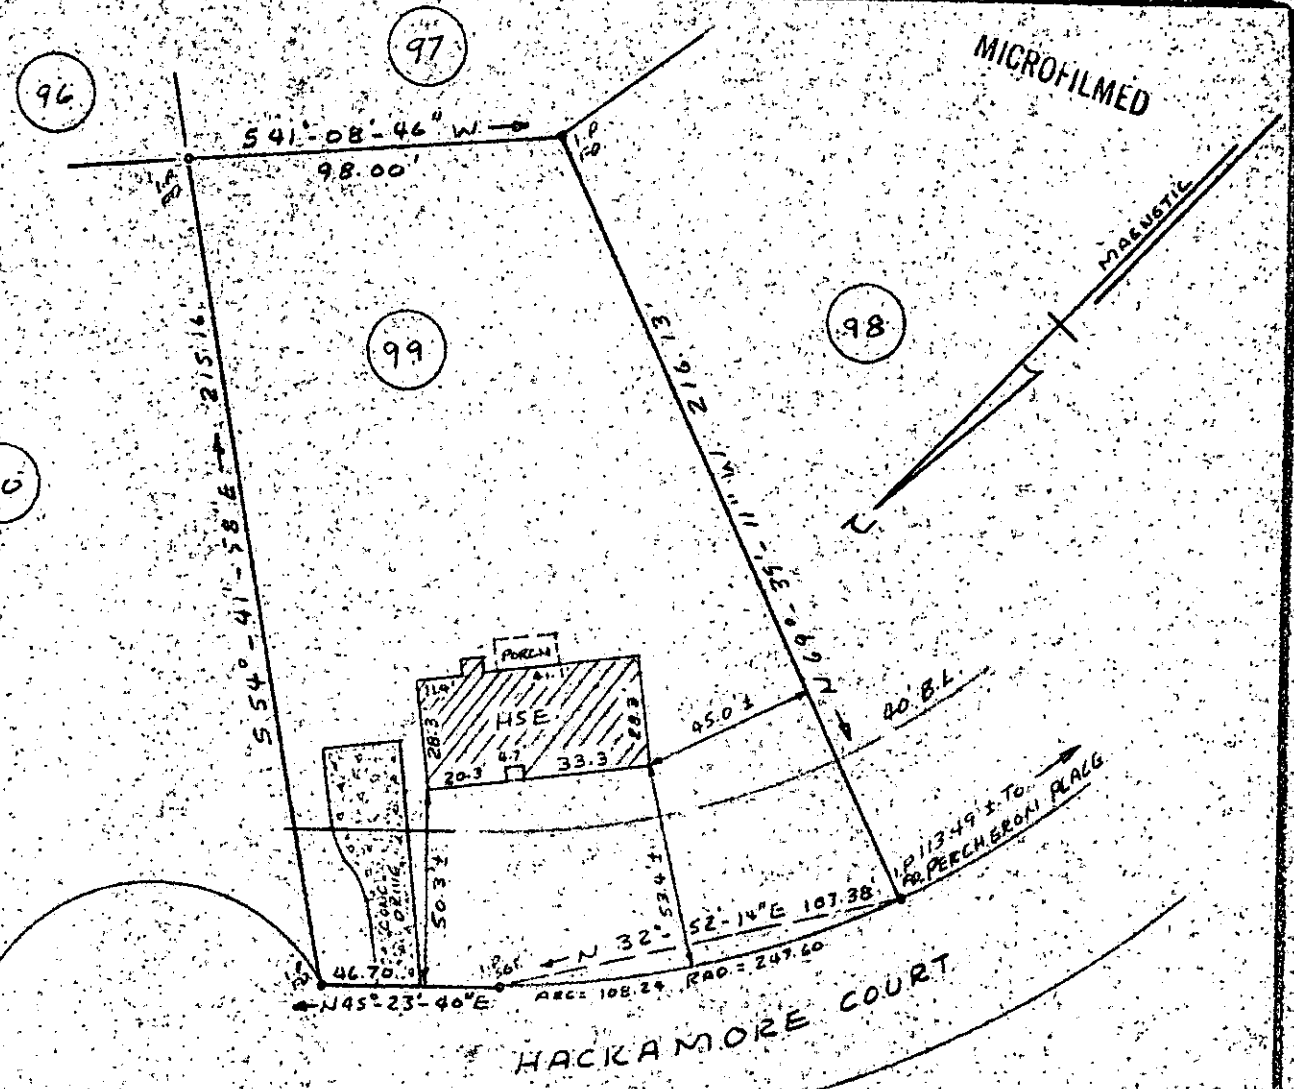

FILED
 GREENVILLE CO. S.C.
 AUG 17 9 50 AM '81
 DONNIE S. TANKERSLEY
 R.M.C.

PROPERTY OF
STEPHEN BRUCE HARRIS &
BARBARA MARTIN HARRIS

NEAR GREENVILLE, SOUTH CAROLINA
AUG. 13, 1981 SCALE: 1" = 50'

This is to certify that on Aug. 13, 1981, I surveyed the property shown on this plat, known as Lot No. 99 of Heritage Lakes Subdivision, as shown on a plat recorded in the RMC Office for Greenville County, in Plat Book G-H, Page 18, and that the property lines, walls and buildings are as shown hereon, and that the building located on said lot does not project nor encroach on adjacent streets or property, and that no adjacent walls or buildings project nor encroach on said lot, and that no utility lines cross this lot except for service thereto, and that the degree of accuracy is 1/10,000.

NOTE: This property is not located within a flood hazard area.

Survey by: Richard L. Wooten, Jr.
 Greenville, South Carolina

10 foot utility and drainage easement along side and rear lines.

Richard L. Wooten, Jr.
 S. C. R. L. C. No. 4678

AUG 17 1981 4318

NOTE
 8-8-81

100-8-32011801