AF 10505

MICROFILMED

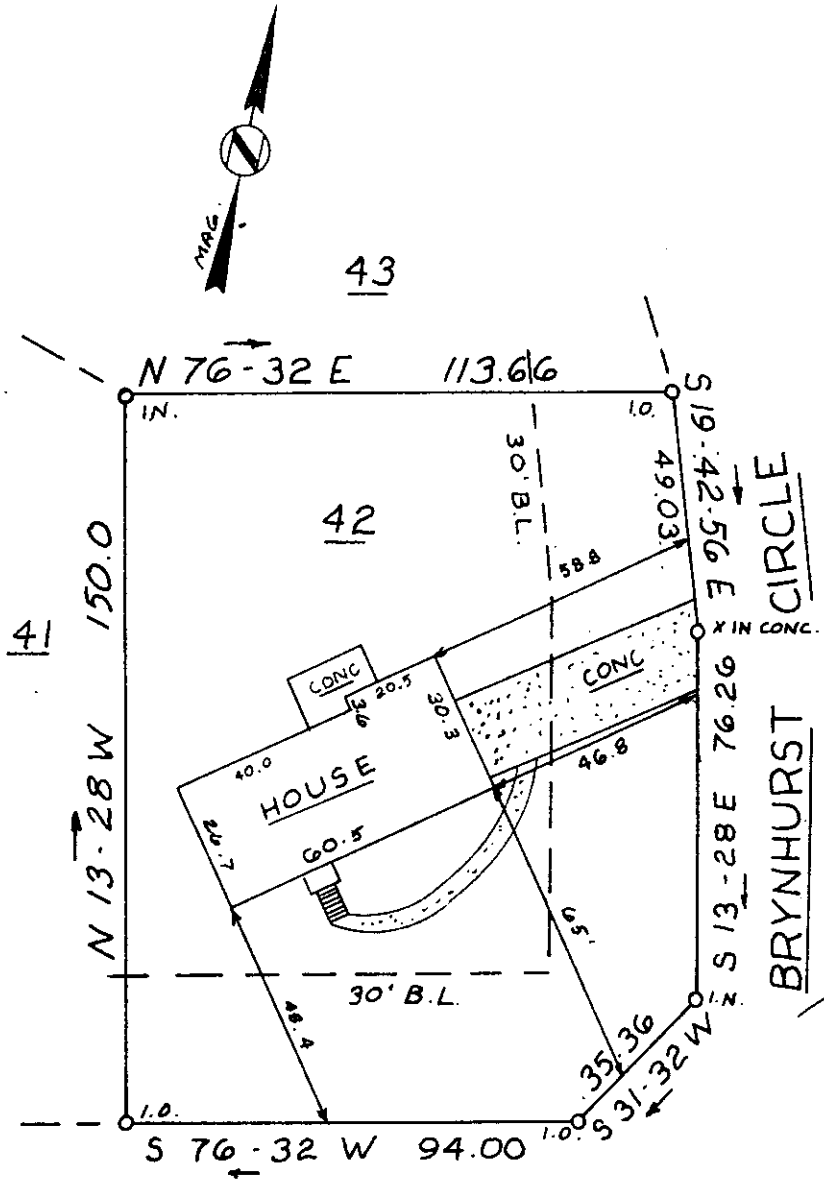

This is to certify that on August 19, 1981, I surveyed the property shown on this plat, known as Lot 42 on plat of Brookfield West Sec. 2, recorded in the R/C Office of Greenville County in Plat Book 7X on page 88, and that the property lines, walls and buildings are as shown hereon; that the building located on said lot does not encroach or project on adjacent streets or property, and that no adjacent walls or buildings encroach or project on said premises, and that no utility lines cross this property except as shown hereon. This property is not located in a designated flood hazard area.

5' drainage and utility easement along side lot lines, and 10' easement along rear lot lines.

James R. Freeland RLS & PE 4781

FILED
GREENVILLE CO. S.C.
AUG 24 11 47 AM '81
DONNIE S. TANKERSLEY
R.M.C.

8-T-5

4963

40 0 40 80
scale feet

SOUTH CAROLINA REGISTERED LAND SURVEYOR N. 4781 JAMES RALPH FREELAND
SEAL

STATE OF SOUTH CAROLINA
GREENVILLE COUNTY

BROOKFIELD WEST
SEC. 2 - LOT 42
PROPERTY OF
WILLIAM R. WITHERSPOON
JANICE K. WITHERSPOON

FREELAND & ASSOCIATES
Engineers • Land Surveyors
GREENVILLE, S.C.

SURVEY	LT
DRAWN	KES
CHECK	MK
SCALE	1" = 40'
DATE	8-19-81
DWG. NO.	6799 3.00CI

PRINT MACHINE INC.

GCTO 3 AUG 24 81 1524