AF 10505

MICROFILMED

FILED
GREENVILLE CO. S.C.
AUG 25 11 27 AM '81
DONNIE S. TANKERSLEY
R.M.C.

This is to certify that on August 14, 1981, I surveyed the property shown on this plat, known as Lot 58 on plat of Homestead Acres Plat I, recorded in the RMC Office of Greenville County in Plat Book RR on page 35, and that the property lines, walls and buildings are as shown hereon; that the building located on said lot does not encroach or project on adjacent streets or property, and that no adjacent walls or buildings encroach or project on said premises, and that no utility lines cross this property except as shown hereon. This property is not located in a designated flood hazard area.

James R. Freeland
James R. Freeland RLS & PE 4781

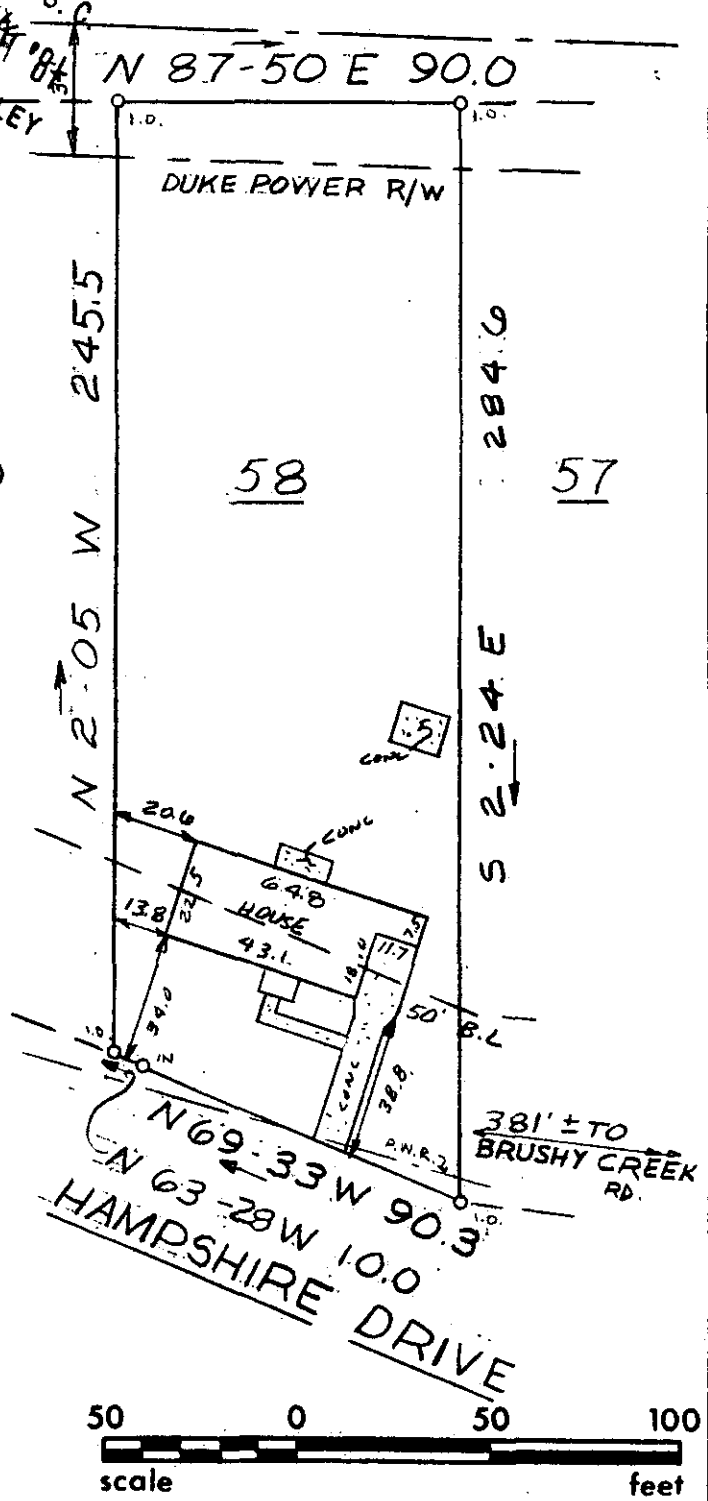

8-T-7

5070

AUG 25 1981

SOUTH CAROLINA REGISTERED LAND SURVEYOR NO. 4781 JAMES RALPH FREELAND

SEAL

STATE OF SOUTH CAROLINA
GREENVILLE COUNTY

HOMESTEAD ACRES
LOT 58
PROPERTY OF
MICHAEL T. HAWKINS
NANCY J. HAWKINS

CCTO 3 AU25 81

FREELAND & ASSOCIATES
Engineers • Land Surveyors
GREENVILLE, S.C.

SURVEY	LT
DRAWN	KES
CHECK	MLC
SCALE	1" = 50'
DATE	8-14-81
DWG. NO.	87853.00CI

PRINT MACHINE INC.