MICROFILMED

AF 10505

FILED
GREENVILLE CO. S. C.
AUG 27 3 08 PM '81
DONNIE S. TANKERSLEY
R.M.C.

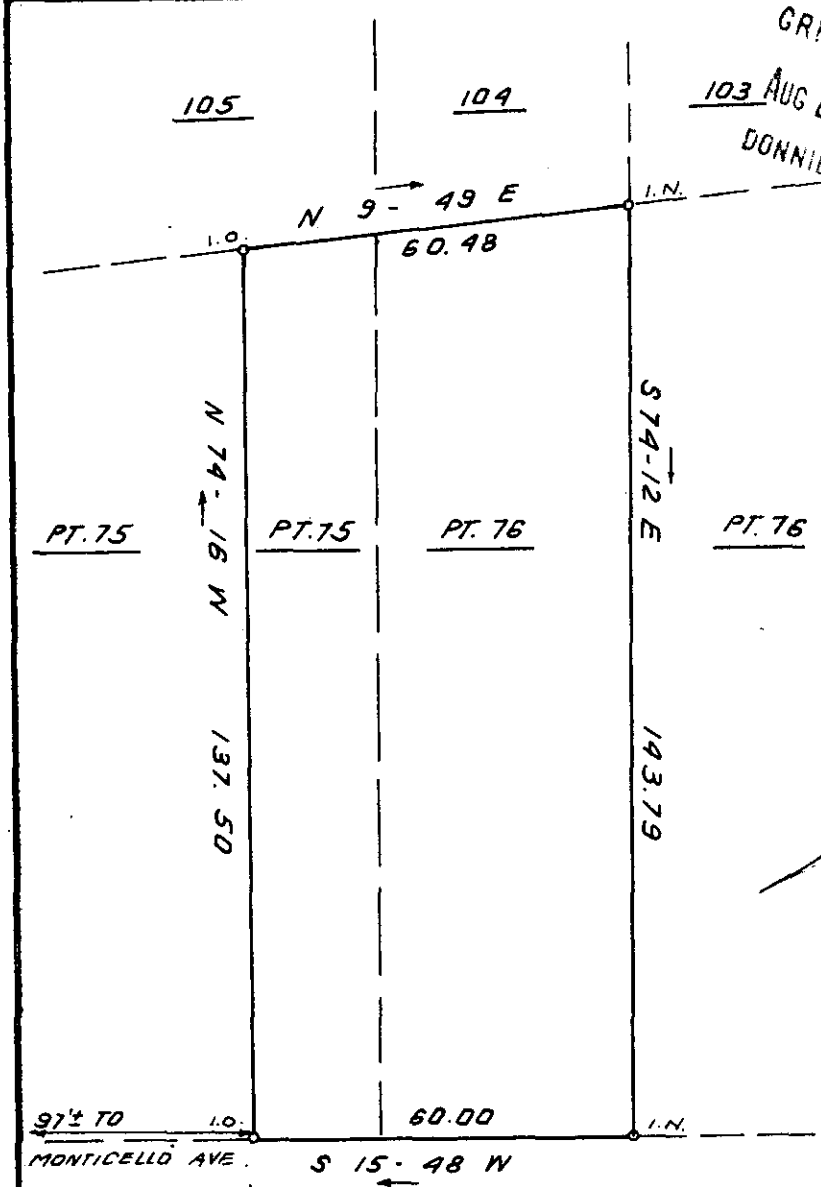

This is to certify that on August 10, 1981, I surveyed the property shown on this plat, known as Lot 76 & Pt. Lot 75 on plat of Glenn Grove Park, recorded in the RMC Office of Greenville County in Plat Book F on page 233, and that the property lines, walls and buildings are as shown hereon; that no adjacent walls or buildings encroach or project on said premises, and that no utility lines cross this property except as shown hereon. This property is not located in a designated flood hazard area.

James R. Freeland RLS & PE 4781

8-7-15

AUG 27 1981

5310

30 0 30 60
scale feet

SOUTH CAROLINA REGISTERED LAND SURVEYOR NO. 4781 JAMES RALPH FREELAND

SEAL

STATE OF SOUTH CAROLINA
GREENVILLE COUNTY

GLENN GROVE PARK
PT. LOT 75 & 76
PROPERTY OF
DORIS RUTH DUNCAN

FREELAND & ASSOCIATES
Engineers • Land Surveyors
GREENVILLE, S.C.

SURVEY	MC & JRF
DRAWN	BR
CHECK	MLC
SCALE	1" = 30'
DATE	AUG. 10. 81
DWG. NO.	6760

PRINT MACHINE INC.

GCTO -----3 AU27 81 473 3.00CI