MICROFILMED

FILED
GREENVILLE CO. S.C.
SEP 3 11 19 AM '81
DONNIE S. TANKERSLEY
R.M.C.

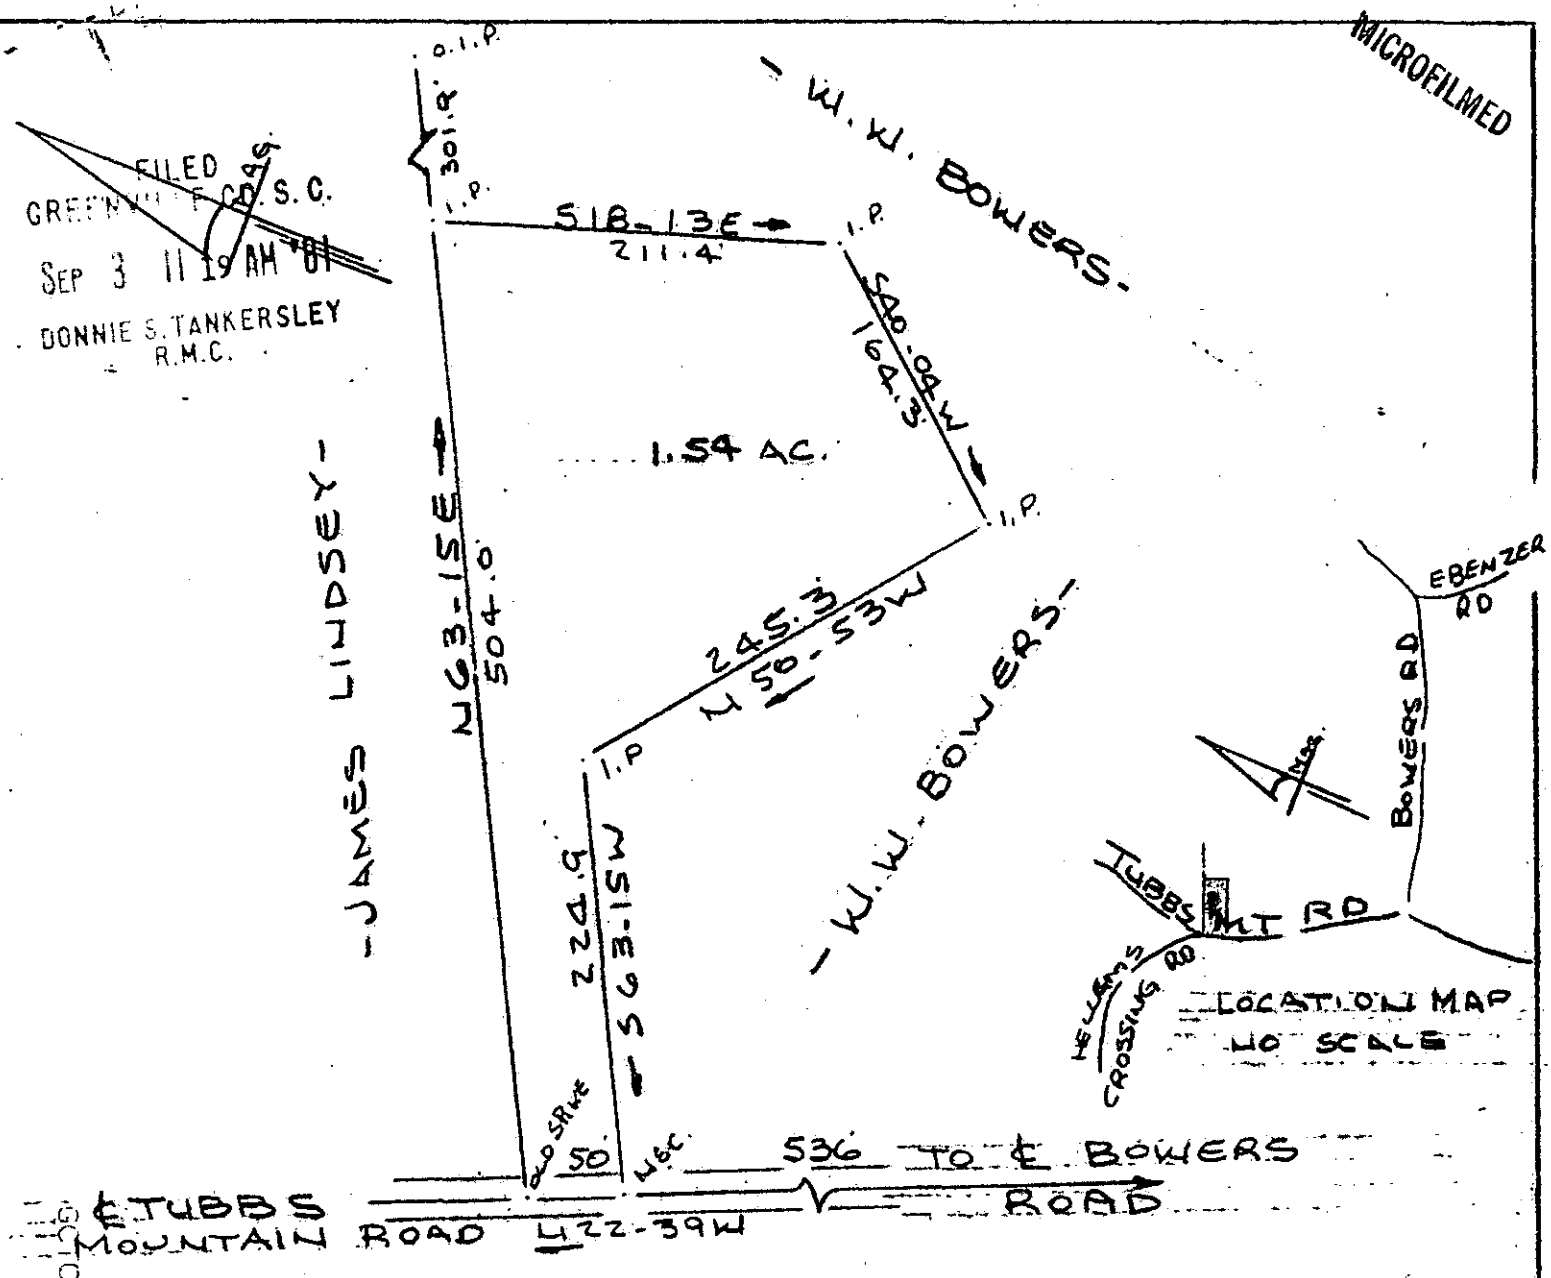

SURVEY FOR
RONALD G. BOWERS & CINDY M. BOWERS
NEAR GREENVILLE, GREENVILLE CO. S.C.
SCALE 1" = 100' 21 AUG 1981

100 50 0 100 200

SEP 3 1981

8-T-29

6038

I Certify That The Ratio Of Precision Of The Field Survey Is 1/3500+ As Shown Hereon And That The Area Determined By D.M.D. Method Of Area Calculations.

R. B. Bruce

CAROLINA SURVEYING CO
112 MANLY ST GREENVILLE, S.C.

1 SE•2 81 036 3.00CI