


FILED  
GREENVILLE, S.C.  
MAR 5 2 46 PM '82  
DONNIE S. WANKERSLEY  
R.M.C.

RECORDED

# PENDLETON STREET

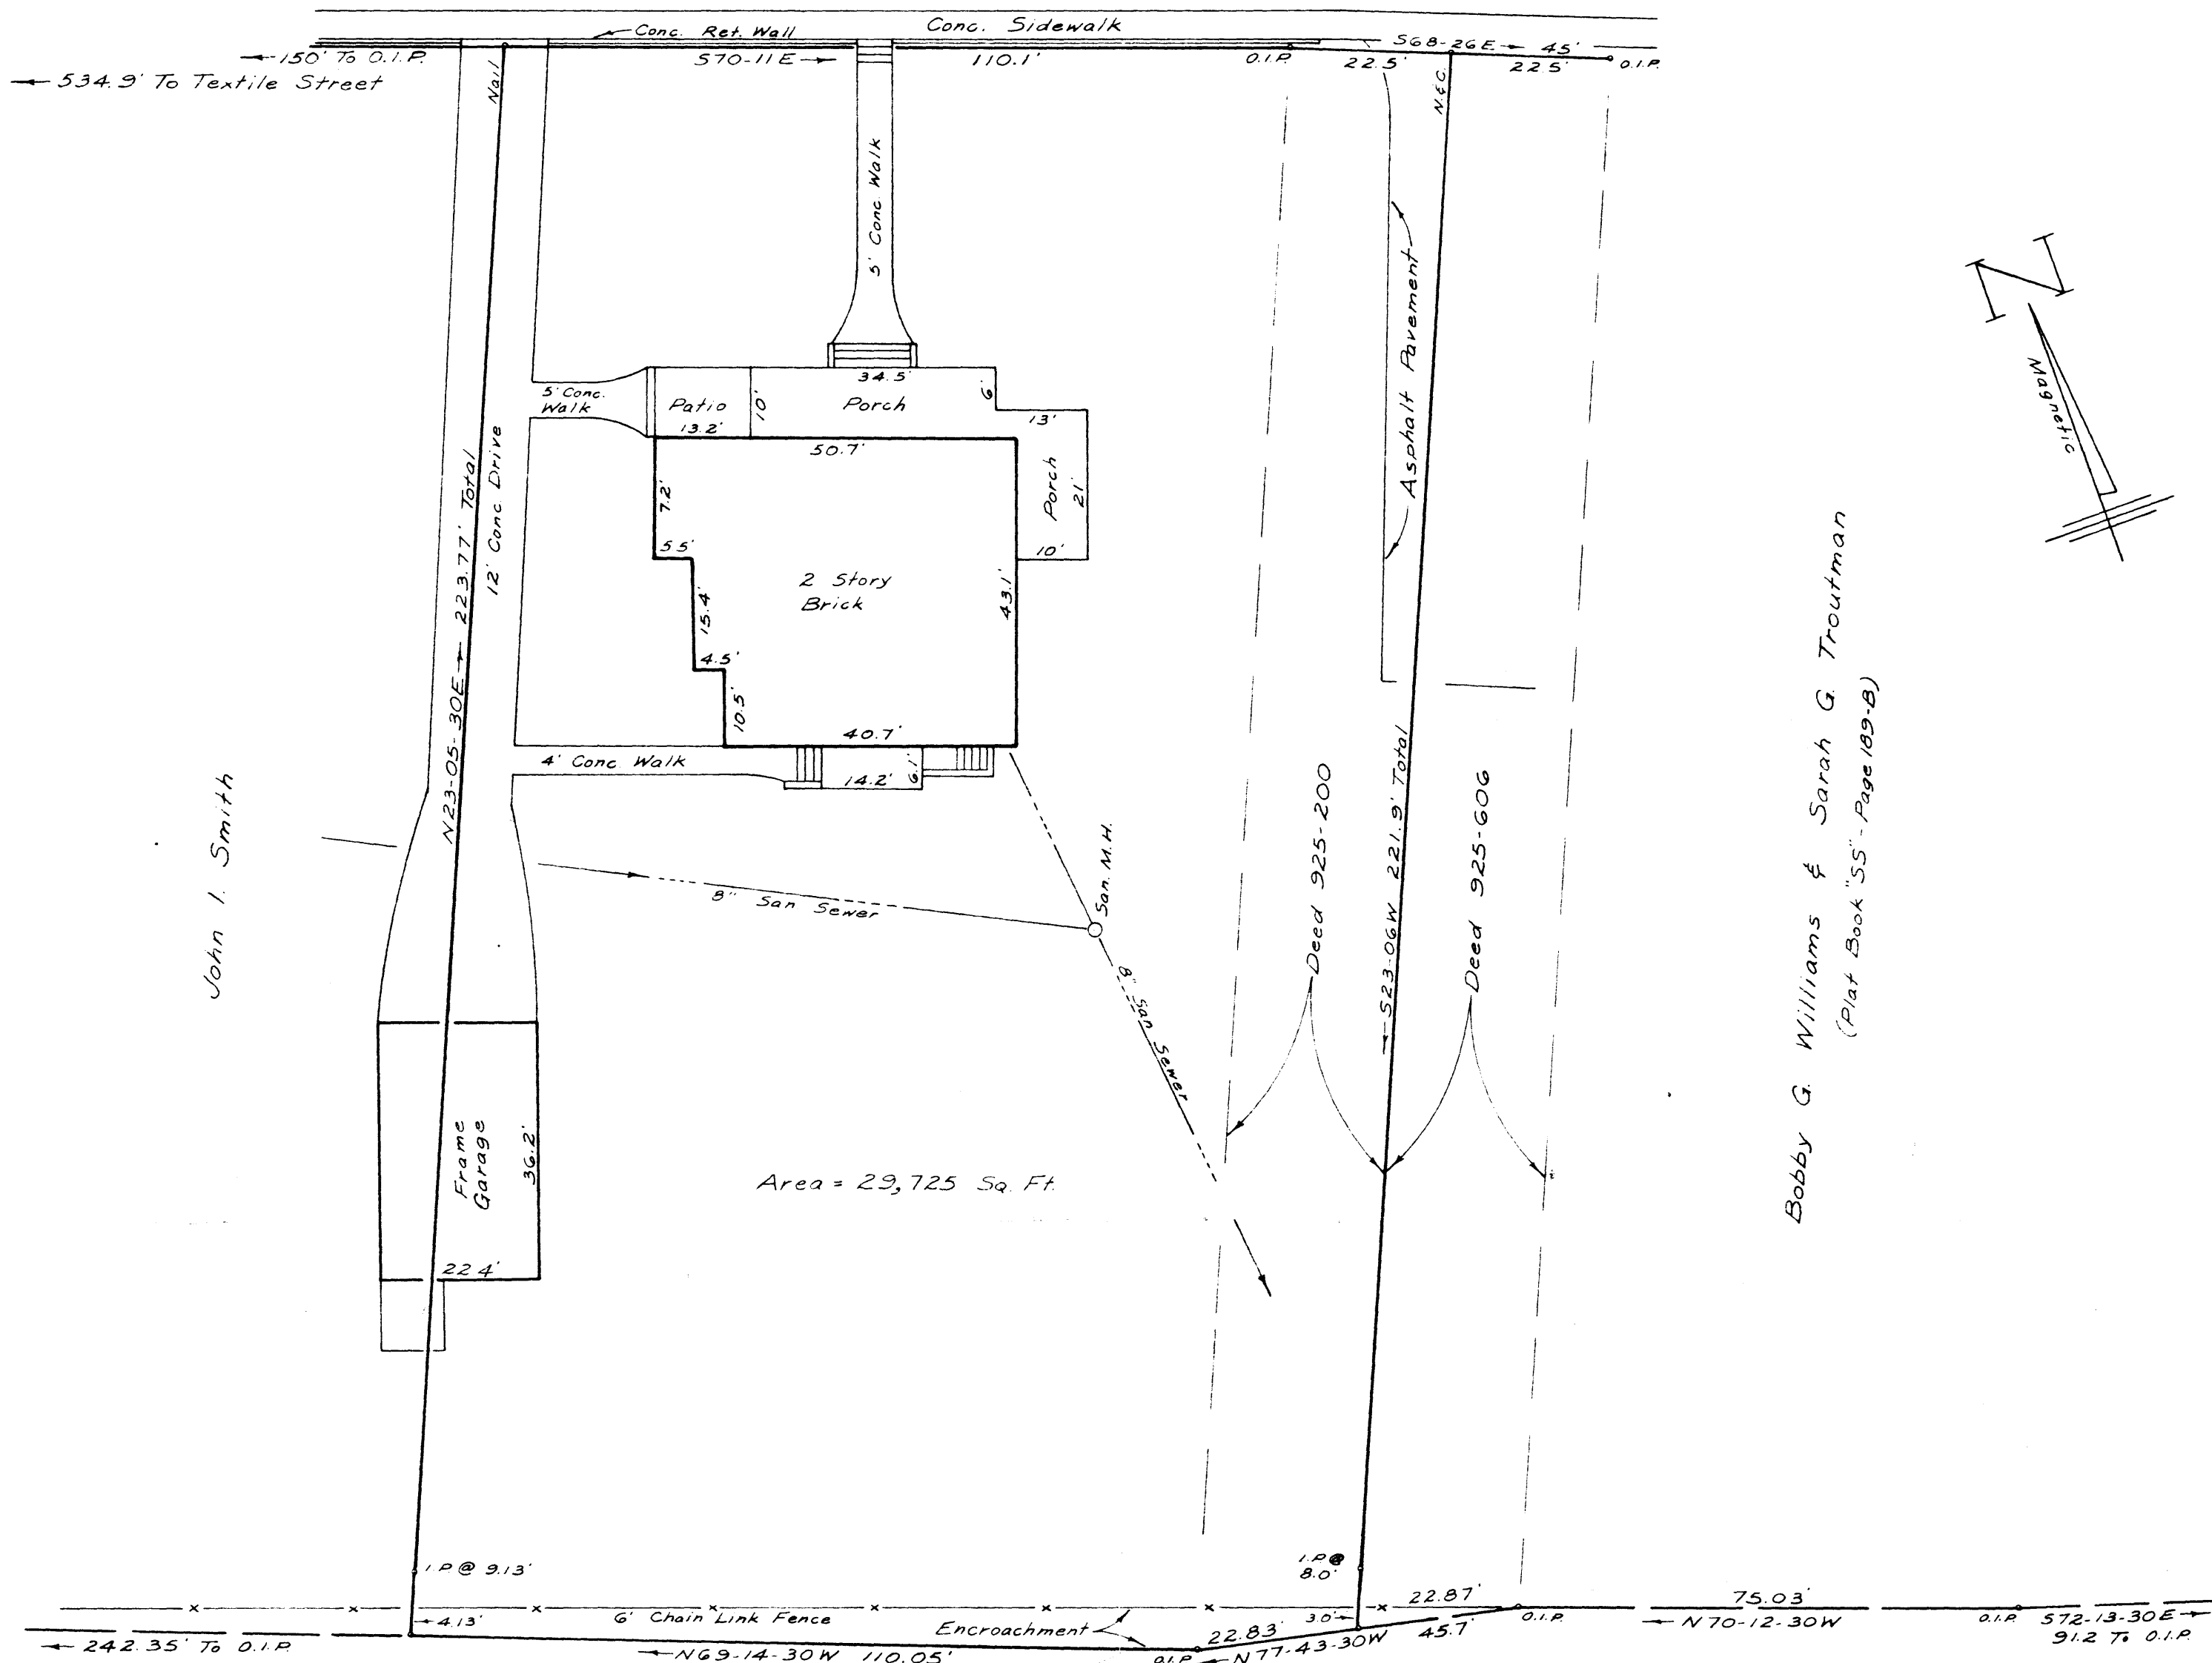

(Rear Property Line As Shown On Plat For The Housing)  
Authority - Plat Book "4G" - Page 135.

The Housing Authority Of The City Of Greenville, S. C.

Ref. Plat No. 1 Brandon  
Subdivision, Plat Book  
"C" - Page 76

## SURVEY FOR GREENVILLE COUNTY REDEVELOPMENT AUTHORITY

GREENVILLE, S. C.

SCALE: 1" = 20' FEB. 10, 1982

W. R. WILLIAMS, JR.  
ENGINEER / SURVEYOR  
P.E. & L.S. No. 3979  
15 S. MAIN ST.  
TRAVELERS REST, S.C.

I Hereby Certify That The Ratio Of Precision  
Of The Field Survey is 1/5000 As  
Shown Hereon And The Area Was Determined  
By D.M.D. Method.

*W.R. Williams, Jr.*