


FILED
GREENVILLE CO. S.C.
NOV 10 4 13 PM '81
DONNIE S. TANKERSLEY
R.M.C.

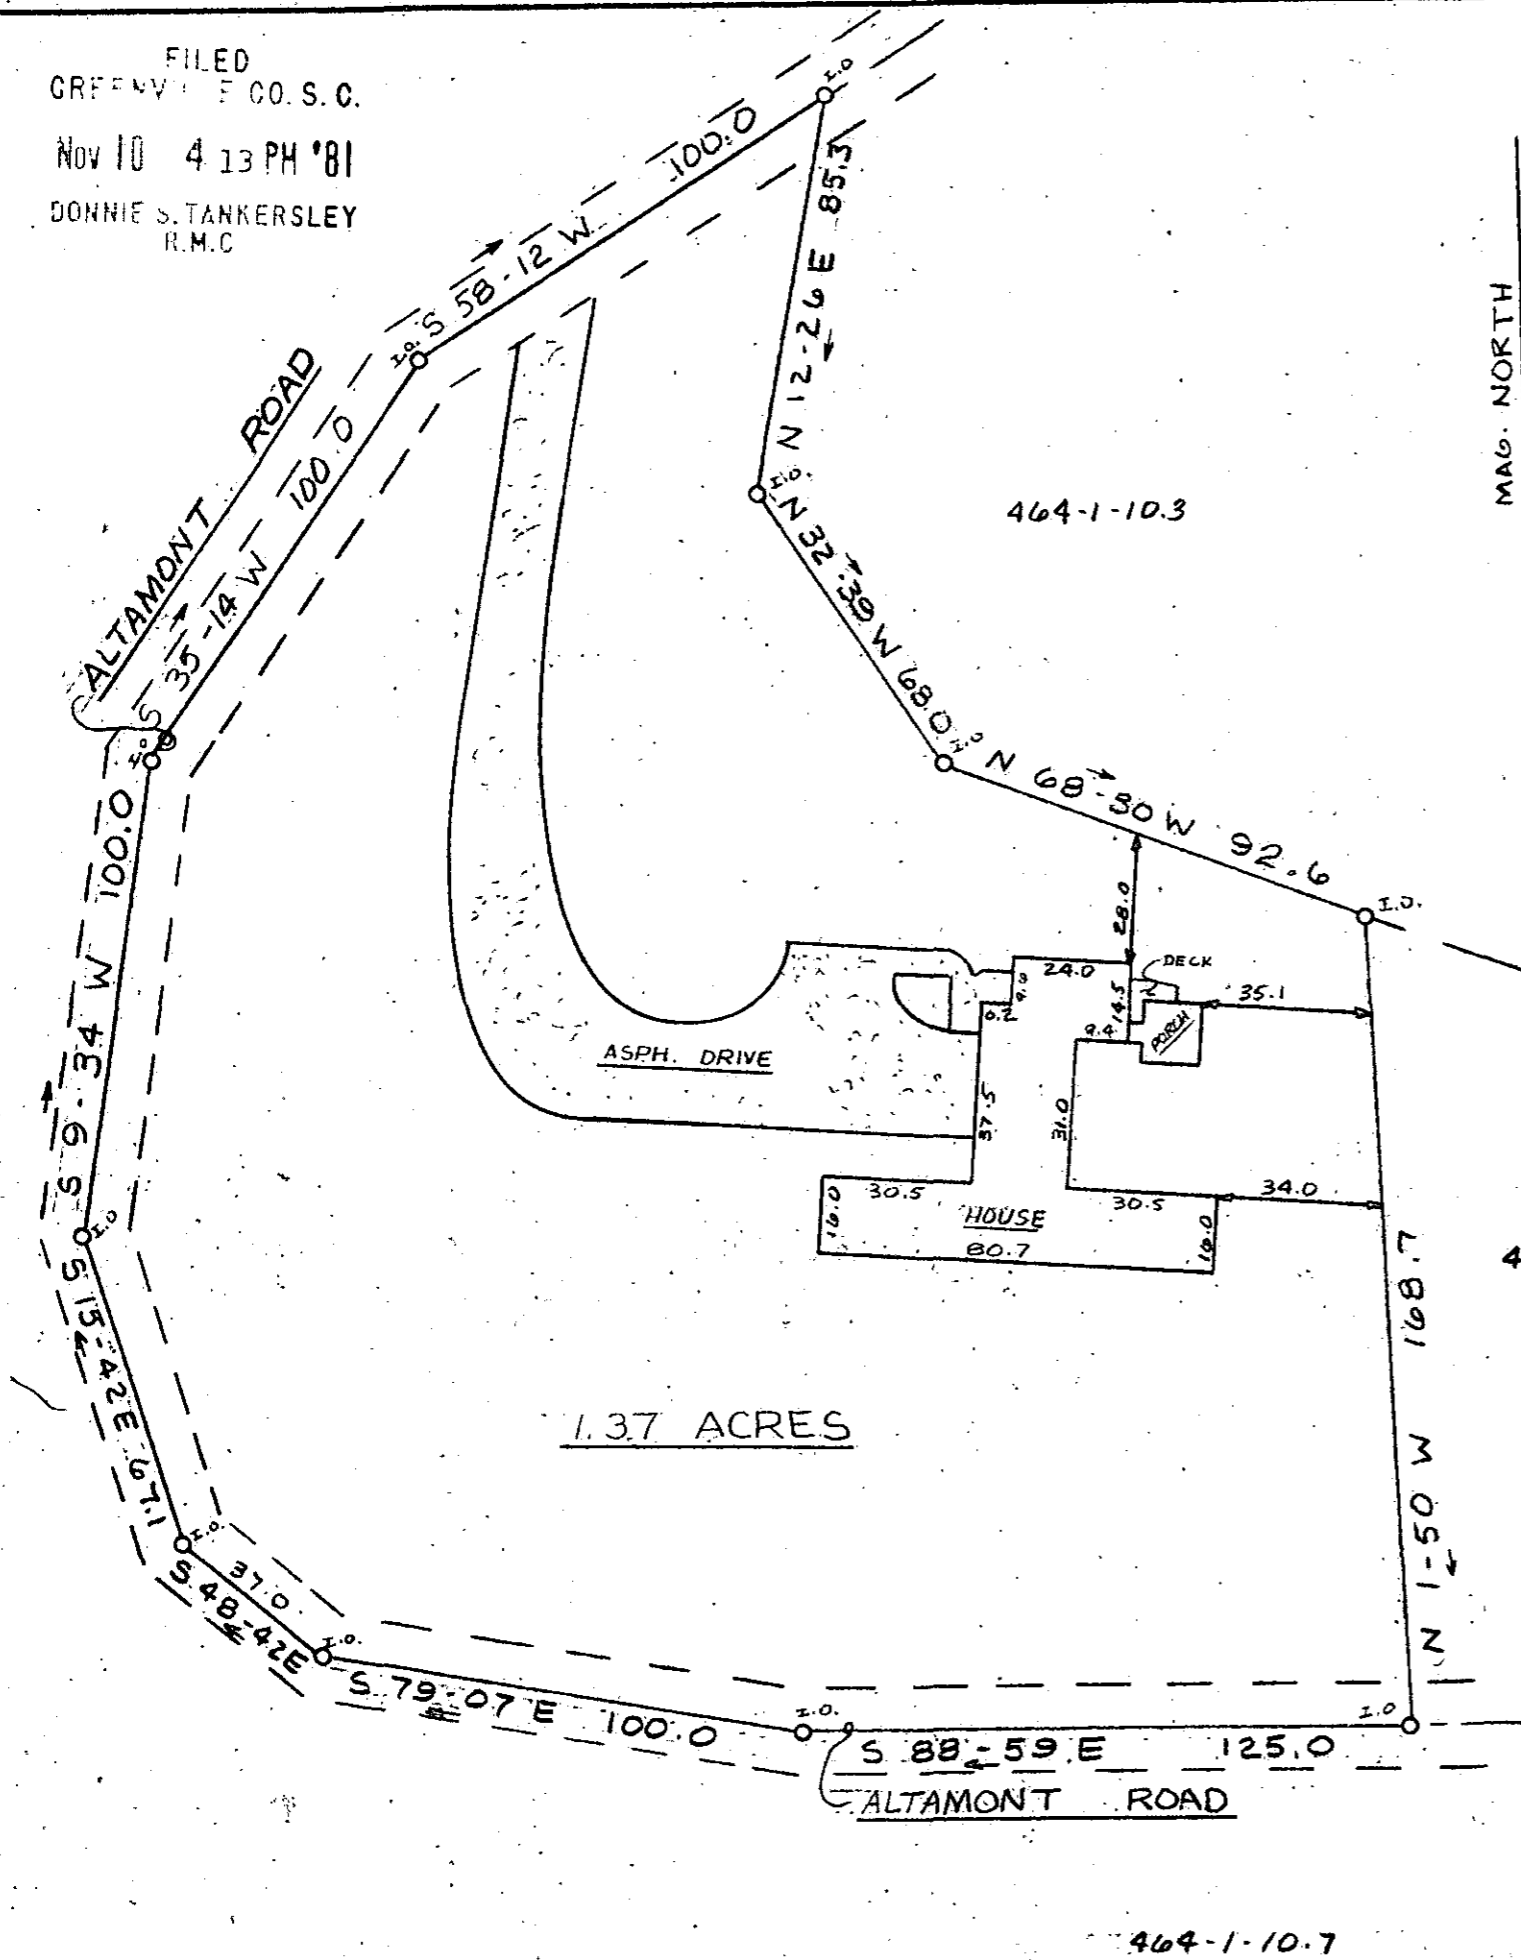

This is to certify that on October 29 1981, I surveyed the property shown on this plat, known as Property of Richard A. Curtis and Dorothy J. Curtis, recorded in the RMC Office of Greenville County in Deed Book 1078 on page 983, and that the property lines, walls and buildings are as shown hereon; that the building located on said property does not encroach or project on adjacent streets or property, and that no adjacent walls or buildings encroach or project on said premises, and that no utility lines cross this property except as shown hereon. This property is not located in a designated flood hazard area.

James R. Freeland
James R. Freeland RLS & PE 4781

8-V-26 ✓

464-1-10.3

NOV 10 1981

11671



STATE OF SOUTH CAROLINA
GREENVILLE COUNTY

PROPERTY OF
JAMES HANSHAW
BRIGITTA HANSHAW

FREELAND & ASSOCIATES
Engineers • Land Surveyors
GREENVILLE, S.C.

SURVEY JC
DRAWN KS
CHECK MKC
SCALE 1"=40'
DATE 10-29-81
DWG. NO. 7003

464-1-10.7

SEAL

5.00 8 742180.1

MICROFILMED