

Area - 44,766 Sq. Ft.
= 1.03 Acre

PROPERTY & FOUNDATION
SURVEY FOR

RACHEL BOHNENBERGER

&
OTTMAR G. BOHNENBERGER
SIMPSONVILLE, S. C.

FILED
GREENVILLE CO. S. C.
NOV 30 2 38 PM '81
DONNIE S. TANKERSLEY
R.M.C.


8-V-35

12987

OCT. 7, 1981

NOV 30 1981

SCALE: 1" = 30'

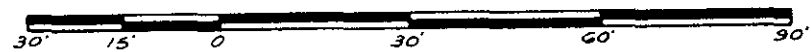

WILLIAMS & PLUMBLEE, Inc.



W. R. WILLIAMS, JR.
ENGINEER / SURVEYOR
P. E. & L. S. No. 3979
15 S. MAIN STREET
TRAVELERS REST, S. C.
29690

"I hereby certify that the ratio of precision of the field survey is 1/6,000+ as shown hereon and the area was determined by DMD method of area calculation."

W.R. Williams, Jr. P. E. & L. S. No. 3979

