


GREENVILLE CO. S. C.

MAR 5 3 32 PM '82

DONNIE S. TANKERSLEY
R.M.C.

MICROFILMED

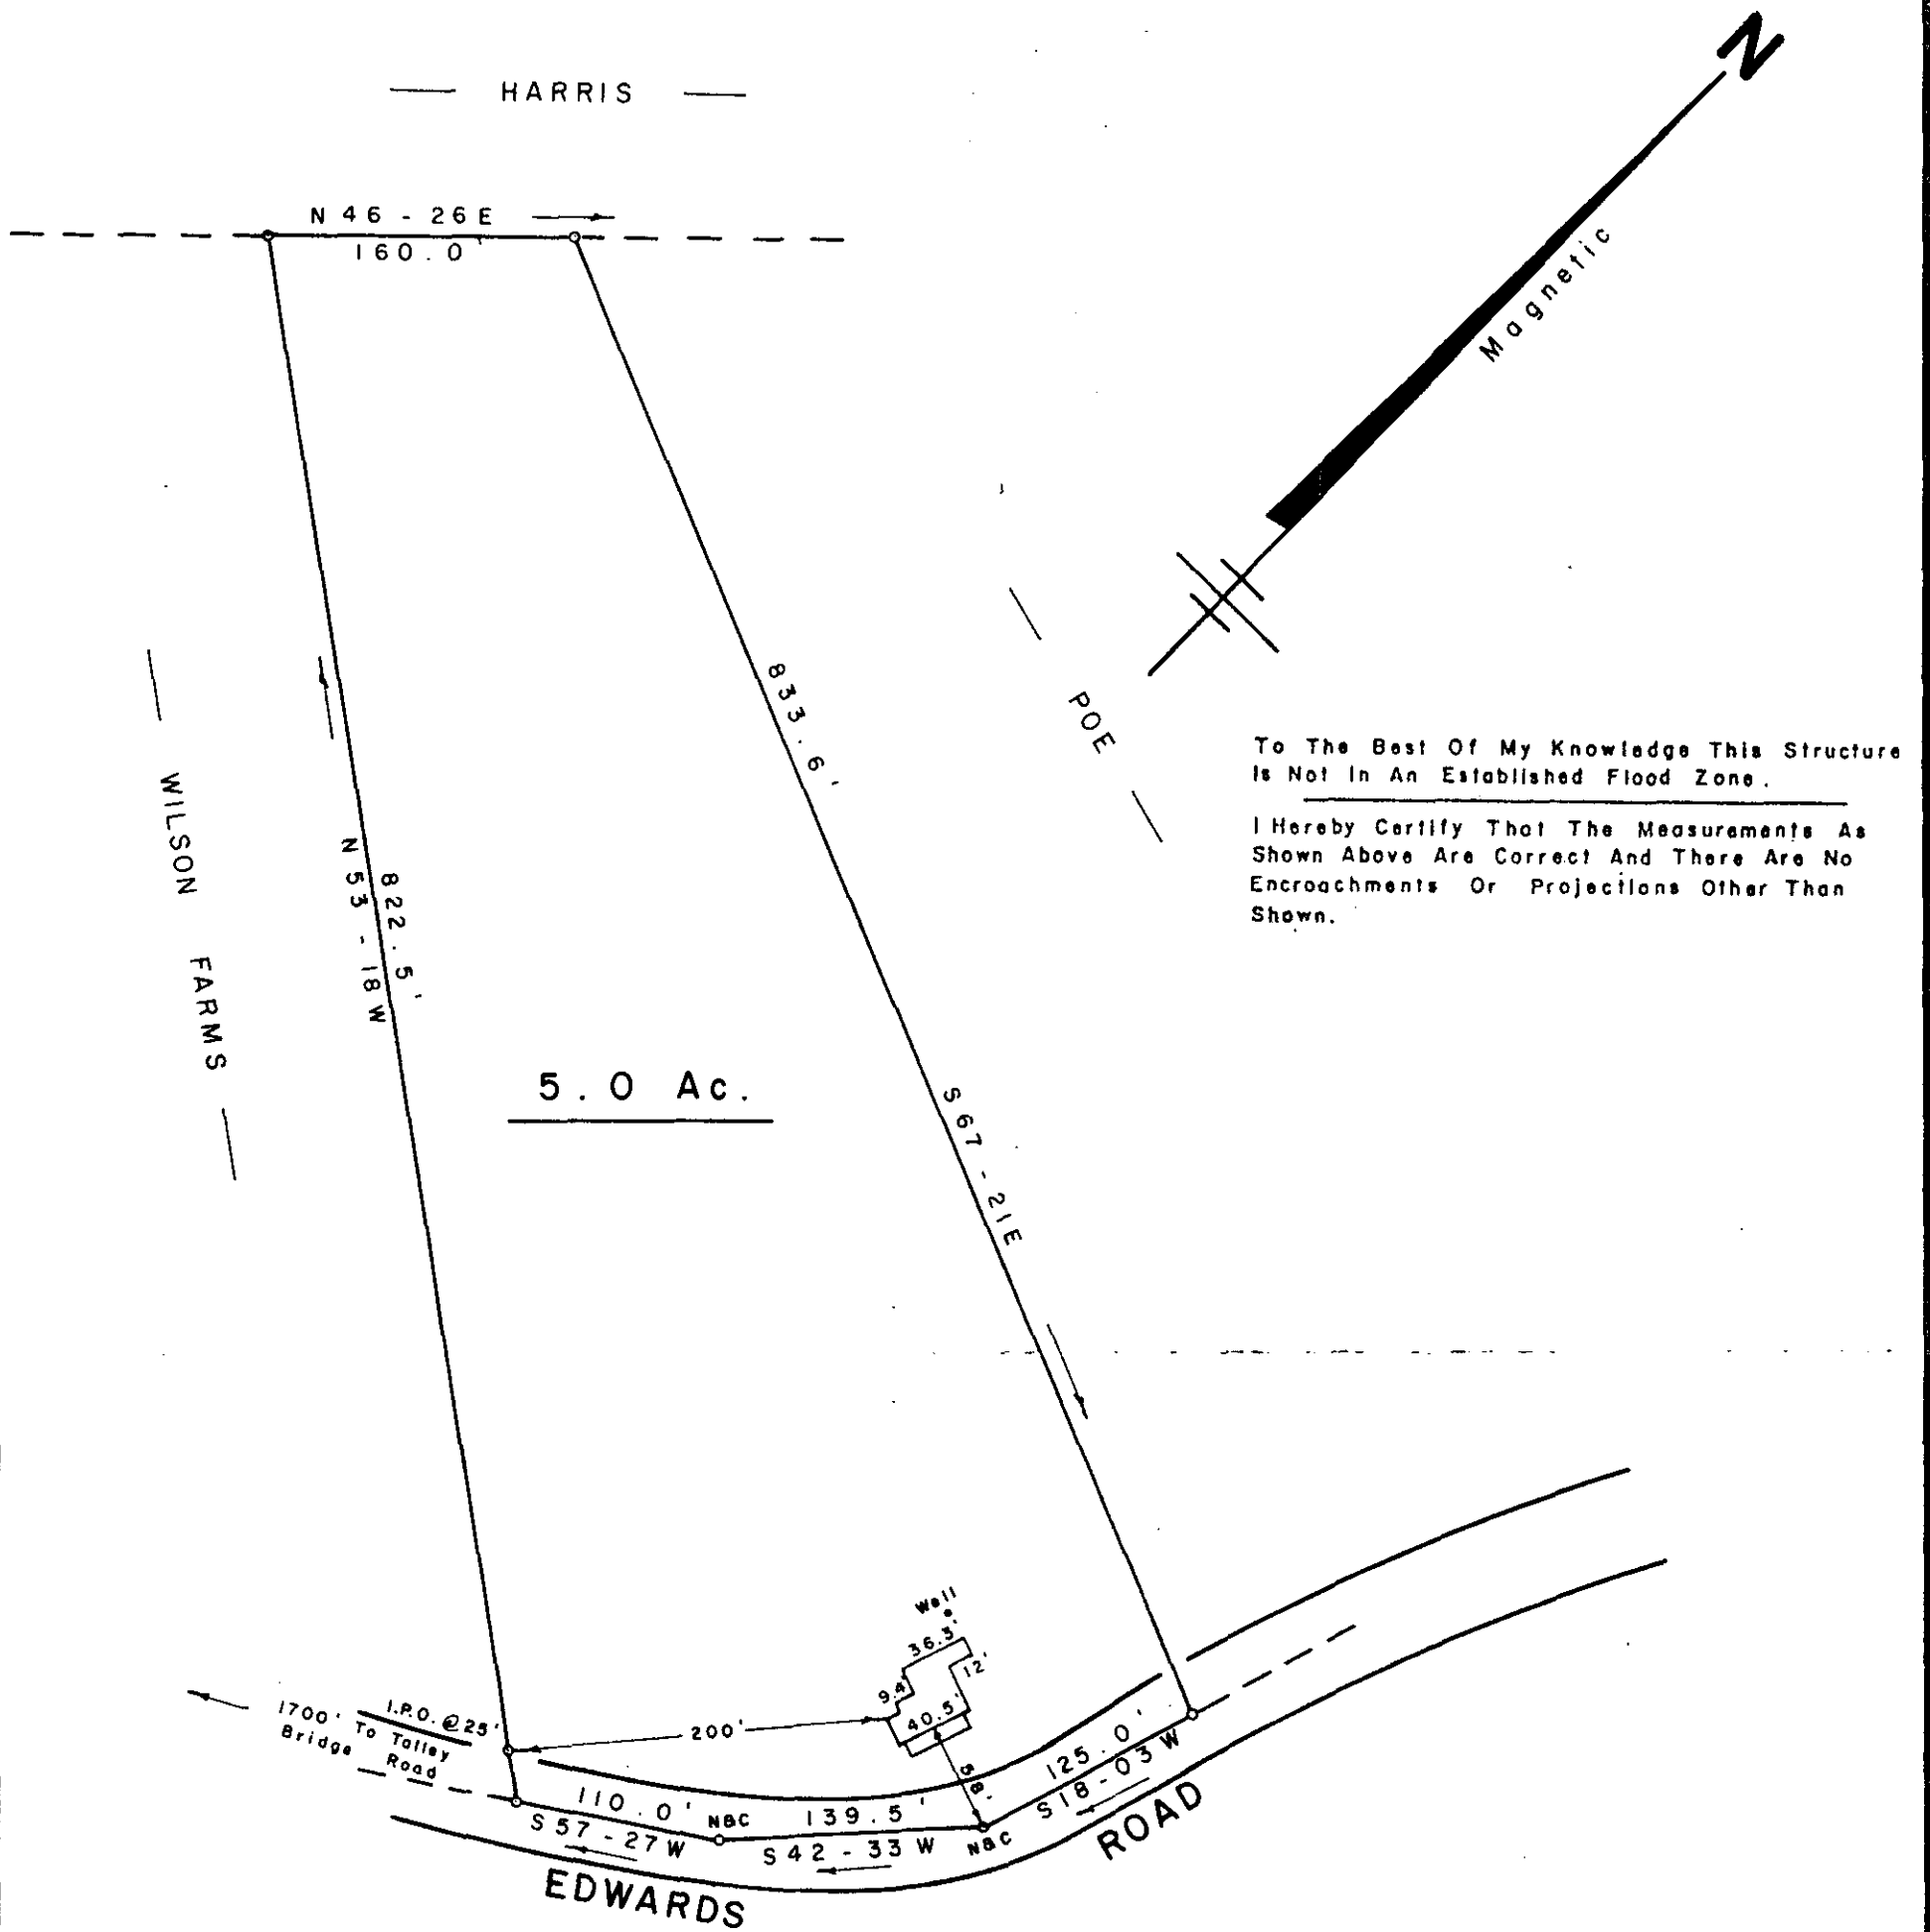


SURVEY FOR
NELSON C. POE, JR.
HEATHER H. POE
 NORTH TRAVELERS REST — GREENVILLE CO.
 SOUTH CAROLINA

19895 FEBRUARY 4, 1982


8-V-101

SCALE: 1" = 100'

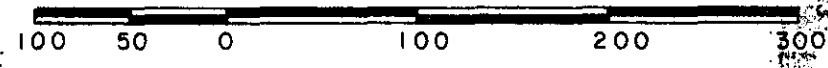

WRW

W. R. WILLIAMS, JR.
 ENGINEER/SURVEYOR
 P. E. & L. S. No. 3979
 15 S. MAIN STREET
 TRAVELERS REST, S. C.
 29690

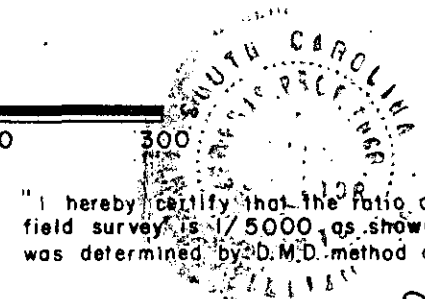

"I hereby certify that the ratio of precision of the field survey is 1/5000, as shown hereon and the area was determined by D.M.D. method of area calculation."

W. R. Williams, Jr. P. E. & L. S. No. 3979