

MICROFILMED

FILED  
GREENVILLE CO. S. C.  
OCT 16 1 45 PM '81  
DONNIE S. TANKERSLEY  
R.M.C.

MS-51-SW  
50


N1-28E  
149.8

MAG  
1968

LIONEL COURT  
WATER & SEWER IN ST ROW

S89-05 W  
140

200  
S85-33E

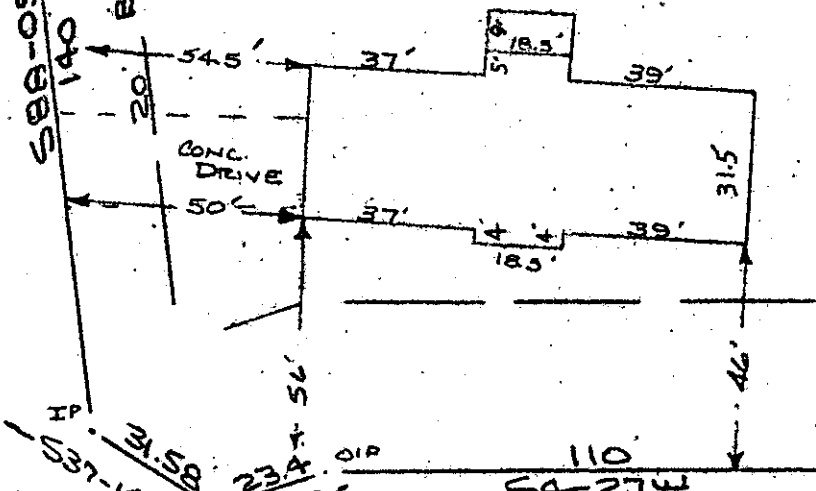

Note: Improvements on this lot are not in a flood hazard area.

35 BL


9692 ✓

8-W-5

OCT 16 1981

LANCELOT DRIVE  
WATER & SEWER IN ST ROW

PROPERTY OF  
STUART JONES & VIRGINIA JONES  
GREENVILLE CO., S. CAROLINA  
SCALE 1" = 40' 23 SEPT. 1981

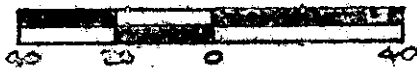

This is to certify that on the 23rd day of September, 1981, I surveyed the property shown on this plot, being known as Lot 46 on plot Sheet One CAMPLOT (now known as HOLLY TREE) recorded in the REC Office Greenville County, S. C., in Plat Book "151" at Page 46; and that the property lines, walls and buildings are as shown hereon, and that the walls and buildings located on said lot do not encroach or project on adjacent street or property, and that no adjacent walls or buildings encroach or project on said premises, and no power lines cross this property except as shown hereon.

*R. B. B...*

CAROLINA SURVEYORS  
112 Holly St., Greenville, S. C.

3CTG -----2 OC16 81 1227

3.00CI