MICROFILMED

FILED
GREENVILLE CO. S.C.
OCT 20 9 05 AM '81
DONNIE S. TANKERSLEY
R.M.C.

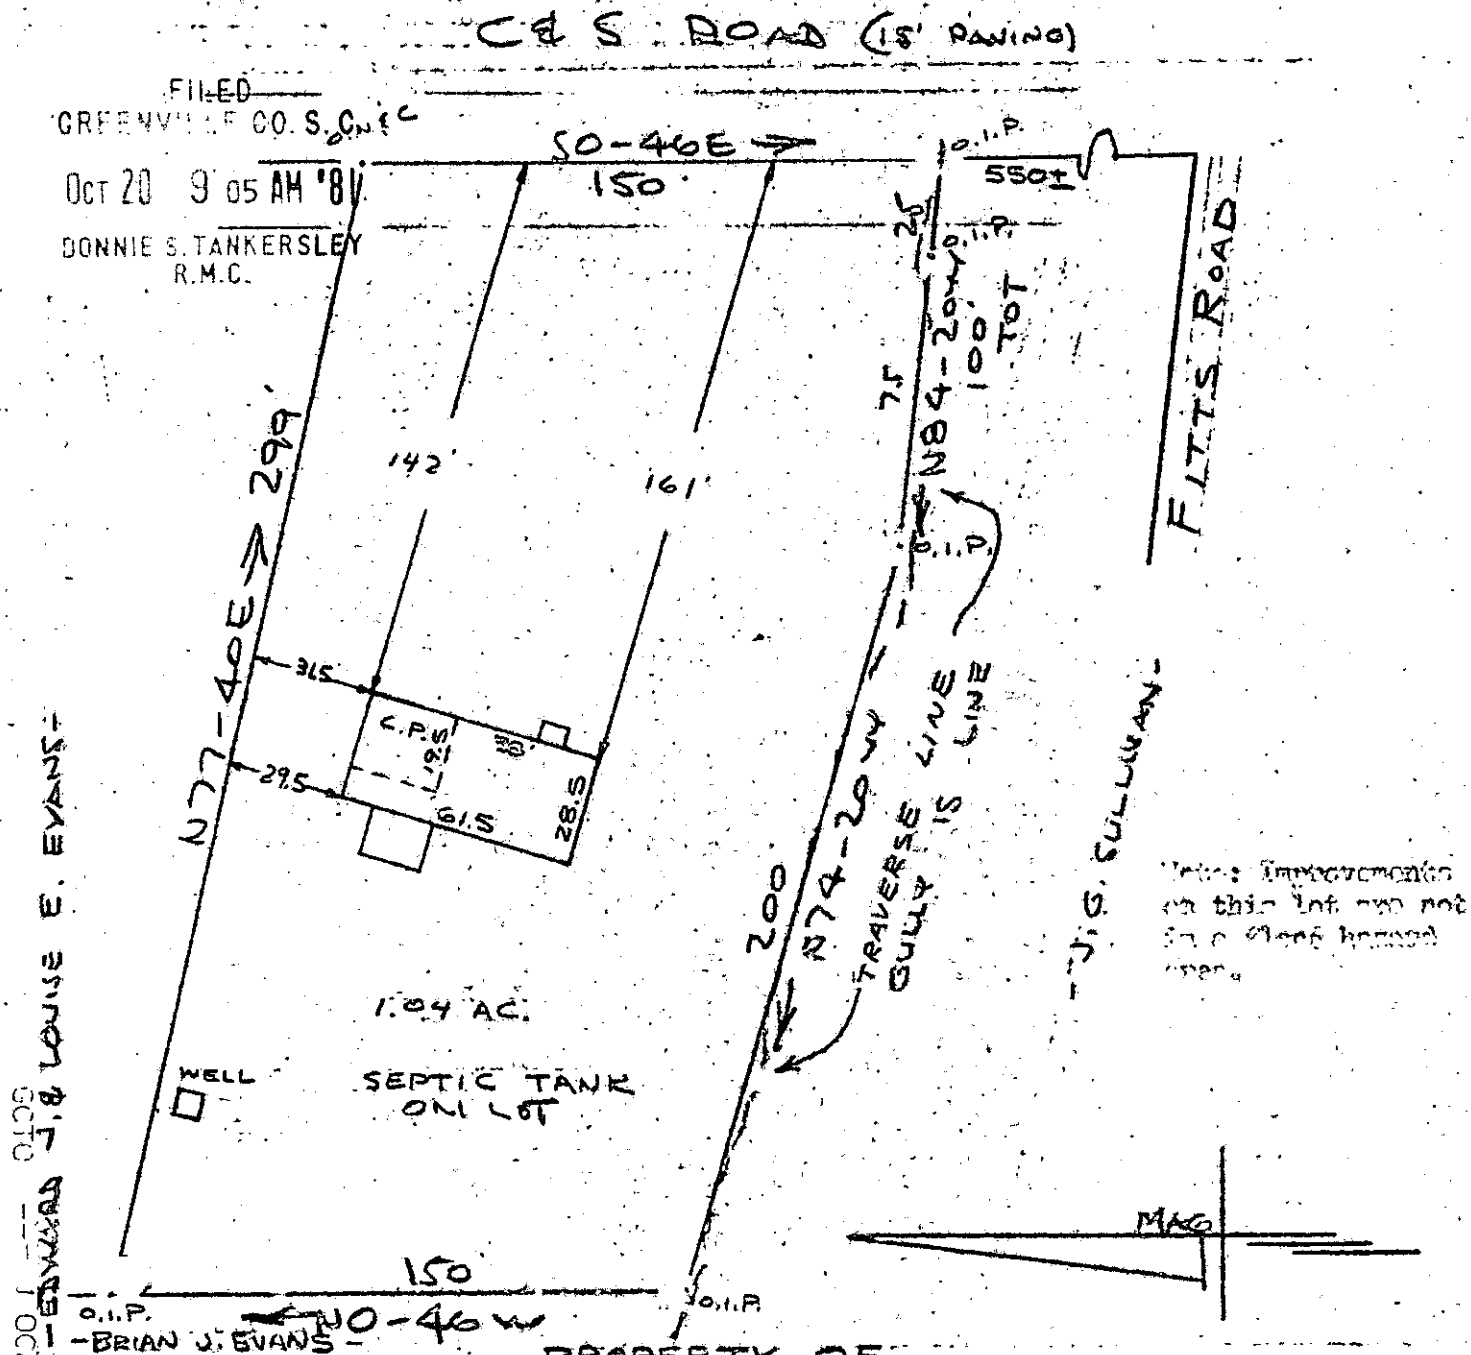

Note: Improvements on this lot are not in a flood hazard area.

PROPERTY OF
ROY S. WOLFE & NANCY C. WOLFE
NEAR GREENVILLE, GREENVILLE CO., S.C.
SCALE: 1" = 50' 12 OCT 1981

50 25 0 50

This is to certify that on the 12th day of October, 1981, I surveyed the property shown on this plat, being known as 1.04 acres on plat of [illegible] & [illegible] and recorded in the RMC Office Greenville County, S. C., in Plat Book " 5 - C " at Page 13; and that the property lines, walls and buildings [illegible] shown hereon, and that the walls and buildings located on said lot do not encroach or project on adjacent street or property, and that no adjacent walls or buildings encroach or project on said premises, and no power lines [illegible] except as shown hereon.

9957

R. B. Bridges

8-W-14

GCTO 1 OC20 81 704 3 OCCI

239@51A, 132/53 630.1-1-1.9 10124