


MICROFILMED

UNDERGROUND UTILITIES

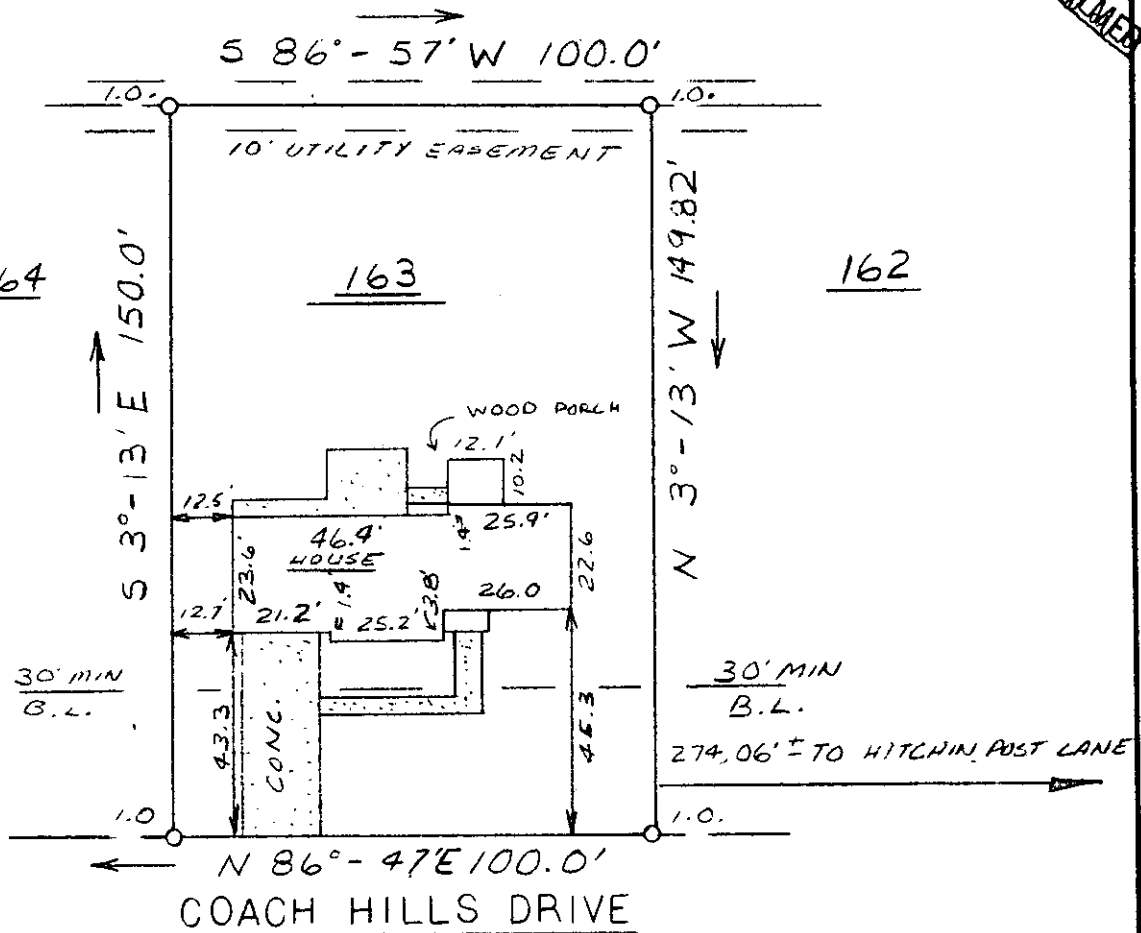

FILED GREENVILLE CO. S.C.

OCT 21 8 50 AM '81

DONNIE S. TANKERSLEY R.M.C.

This is to certify that on September 23, 1981, I surveyed the property shown on this plat known as Lot 163 on Plat of Coach Hills recorded in the REC Office of Greenville County in Plat Book 4X on Page 25, and that the property lines, walls, and buildings are as shown hereon; that the building located on said lot does not encroach or project on adjacent streets or property, and that no adjacent walls or buildings encroach or project on said premises, and that no utility lines cross this property except as shown hereon. This property is not located in a designated flood hazard area.

Note: 5' utility and drainage easement each side of all side and rear lot lines.

James R. Freeland
James R. Freeland R.L.S. & F.F. L761

10082

J-W-19


OCT 21 1981



STATE OF SOUTH CAROLINA
GREENVILLE COUNTY

FREELAND & ASSOCIATES
Engineers • Land Surveyors

GREENVILLE, S.C.

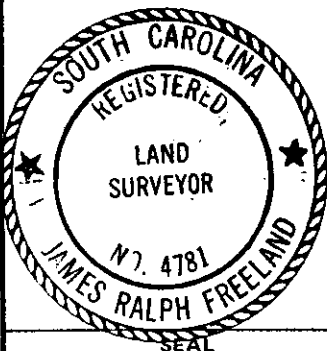

COACH HILLS
LOT 163
PROPERTY OF
ROY H. COX
EUGENIA K. COX

SURVEY W.B.H. II
DRAWN S.P.
CHECK W.B.H. II
SCALE 1" = 40'
DATE 9-23-81
DWG. NO. 81-6892

3802 4785

5020 --- 1002181

804

3.0001