


OLD CHICK SPRINGS RD.

FILED
GREENVILLE CO. S. C.
OCT 29 2 18 PM '81
DONNIE S. TANKERSLEY
R.M.C.

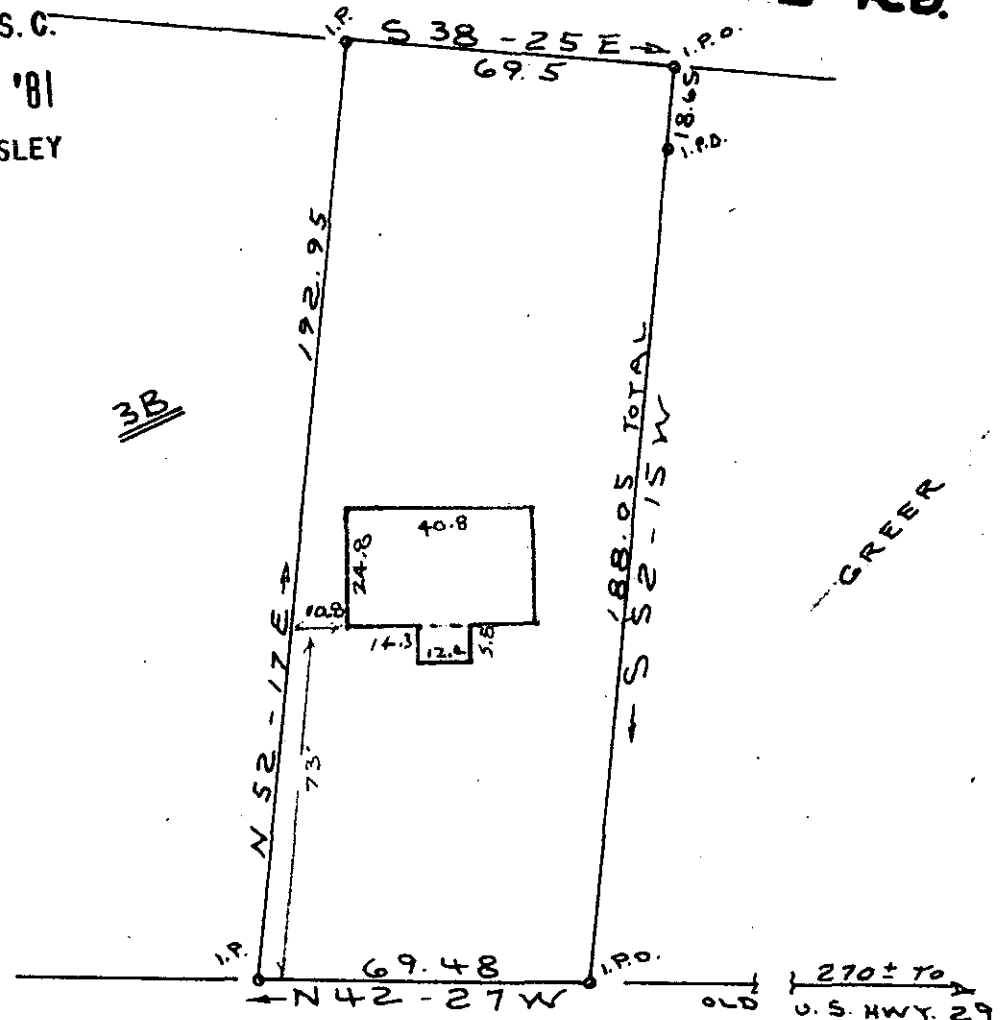

SAINT MARKS ROAD

OCT 29 1981

8-W-36

10729

I Heréby certify that on Oct. 20 1981 I resurveyed the above lot according to a previous survey, and that the property lines, buildings and walls are as shown hereon, that no walls or buildings encroach on adjacent streets or property and no walls or buildings encroach or project on these premises, and that the structure is not within a flood hazard area.

PROPERTY OF
HOWARD E. BAKER SR.

NEAR TAYLORS
GREENVILLE COUNTY S. C.

Charles F. Webb RLS WEBB SURVEYING & MAPPING CO.

SCALE 1" = 40' OCT 1981

GCTO 3 0029 81 050 3.0000

