


MICROFILMED

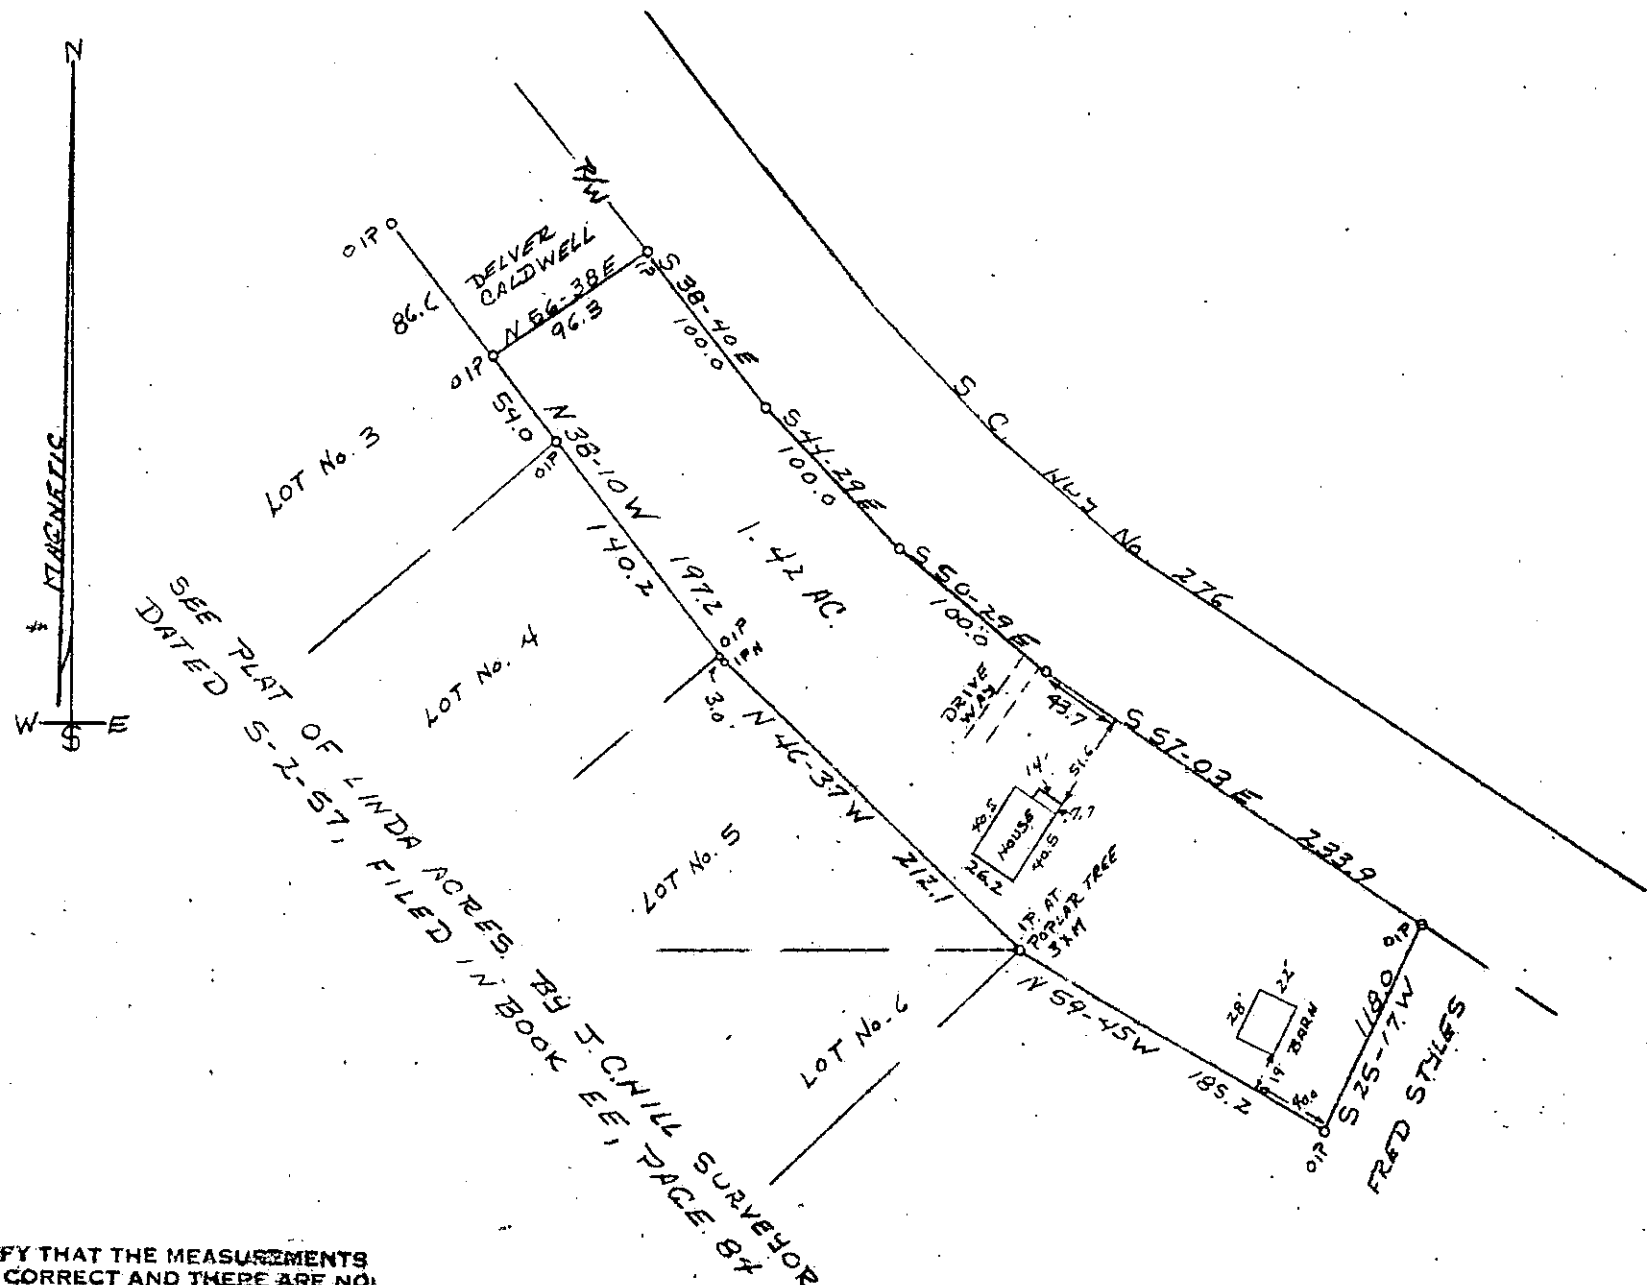

I HEREBY CERTIFY THAT THE MEASUREMENTS AS SHOWN ARE CORRECT AND THERE ARE NO ENCHROACHMENTS OR PROJECTIONS OTHER THAN SHOWN.

PROPERTY OF  
BRUCE HERBERT CALDWELL

THE PROPERTY AND BUILDINGS SHOWN ON THIS PLAT ARE NOT IN A FLOOD HAZARD AREA.

FILED  
GREENVILLE CO. S.C.  
DEC 23 11 58 AM '81  
DONNIE S. TANKERSLEY  
R.M.C.

STATE OF S.C.  
GREENVILLE CO.

THE ABOVE PROPERTY IS LOCATED APPROX ONE MILE SOUTH OF MARIETTA, IN BATES TOWNSHIP

SCALE 1" = 100'

PARTY CHIEF  
FRANK DUNCAN

RECORDED  
GREENVILLE CO. S.C.  
DATE 12-21-81  
NO. 112  
T. CRAIG

14741  
8X-21

3-DE 25-81 No. 0562 L.S. 3.00CD