


MICROFILMED

FILED
GREENVILLE CO. S. C.

JAN 29 2 18 PM '82

DONNIE S. TANKERSLEY
R.M.C.

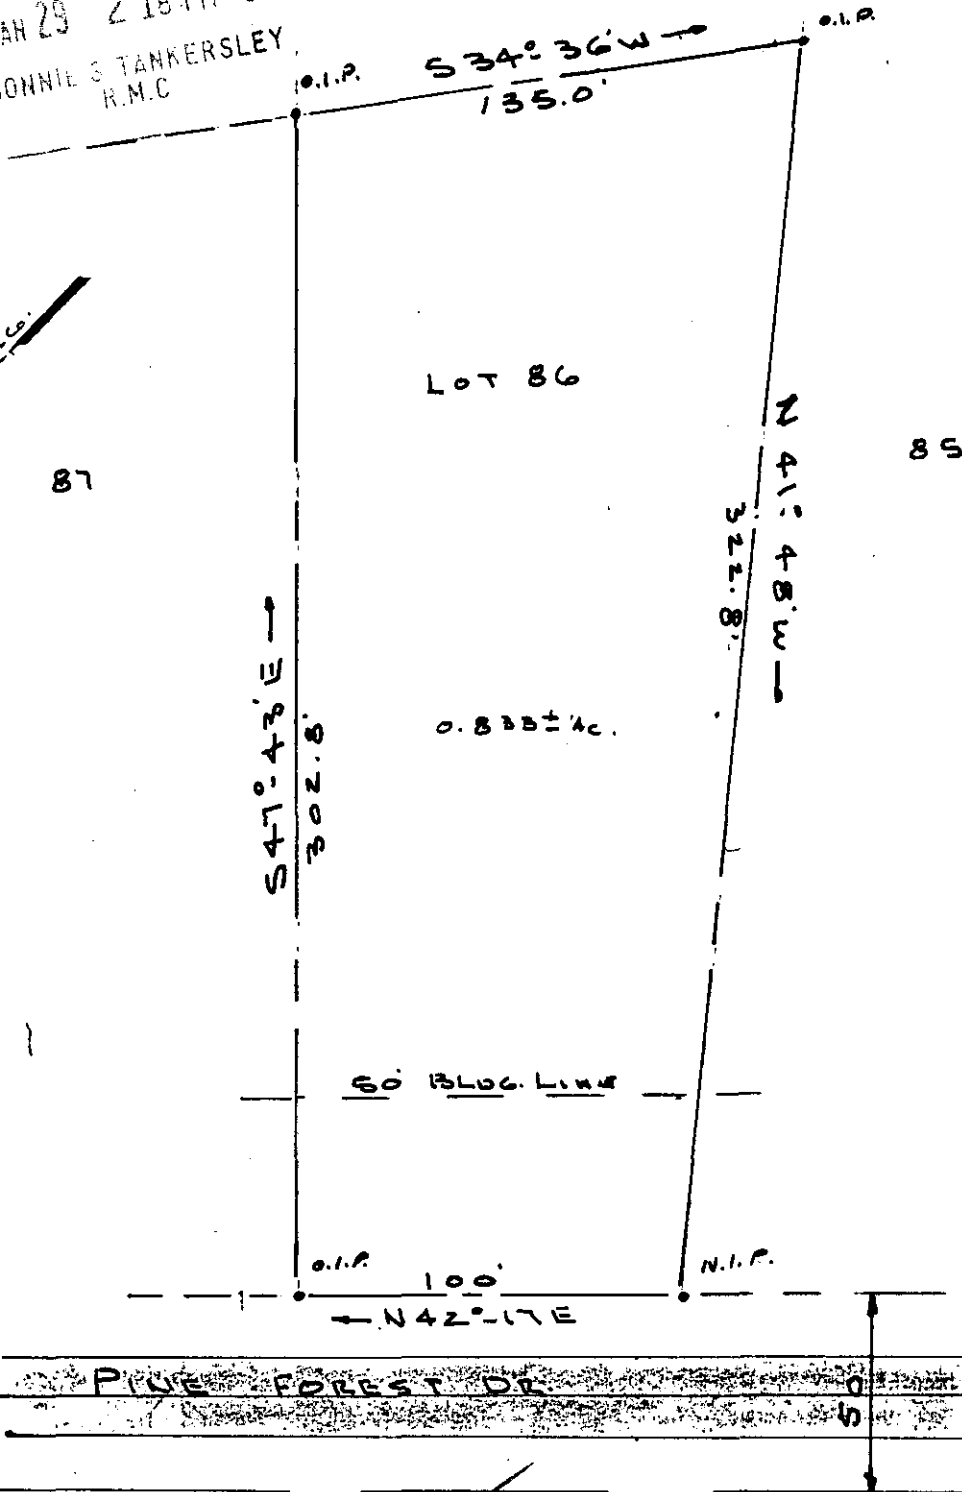

8-X-66 17089

PLT. BK. 4"R" PG. 98
BLK. BK. T-18-2-27
WATER, SEWER, POWER & TEL.
IN STREET.
GREENVILLE CO
GREEN, S.C.

I CERTIFY THE ABOVE LOT HAS
BEEN SURVEYED AND IS AS SHOWN

Kent P. Gould
S. C. REG. NO 4035

	PROPERTY OF McELRATH & TUCKER INC.	Drawn By K.T.G.
	"BELMONT HEIGHTS" SECTION 2	Checked By
	K.T. GOULD INC. SURVEYORS	Scale 1" = 50'
	TAYLORS, GREENVILLE, S.C.	Date 1-9-82
		File No.
		Dwg. No.