


MICROFILMED

H. L. L. GILSTRAP, JR.


Note:  
Improvements on  
this lot are not  
in a flood hazard  
area.

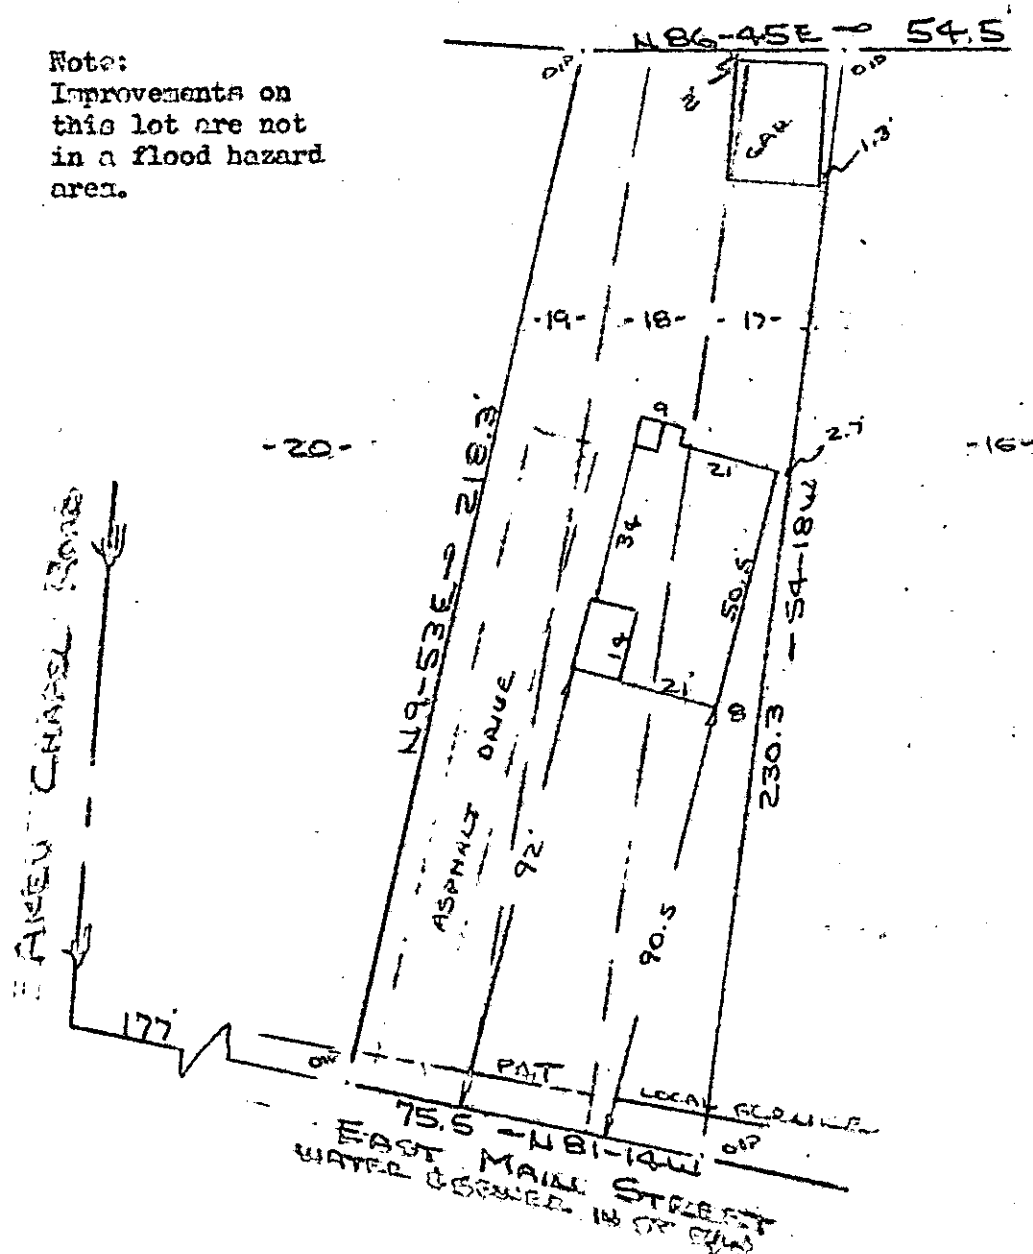

FILED  
GREENVILLE CO. S. C.  
FEB 19 12 00 PM '82  
DONNIE S. TANKERSLEY  
R.M.C.

75.5 - N81-14W  
EAST MAIN STREET  
WATER & SEWER IN OR OVER

PROPERTY OF  
**ROGER D. HIX**  
GREENVILLE COUNTY, TAYLORS, S. C.  
SCALE: 1"=40' 17 FEB 1982

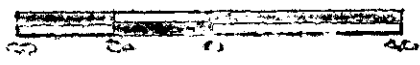

This is to certify that on the 17th day of February, 1982, I surveyed the property shown on this plat, being known as lots 17, 18 & 19 on plat of V. W. STUBBS and recorded in the REC Office Greenville County, S. C., in Plat Book "7" at Page 91 also being known as PROPERTY OF ROGER D. HIX and recorded in Plat Book 8-X at Page 98; and that the property lines, walls and buildings are as shown hereon, and that the walls and buildings located on said lot do not encroach or project on any street or property, and that no adjacent walls or buildings encroach or project on said premises, and no power lines cross this property except as shown hereon.

18718

8-X-98

FEB 19 1982

*R. H. Br...*  
R. H. Br...

CAROLINA SURVEYING CO.  
112 Mainly St.  
Greenville, S.C. 29601

3 FEB 19 82 023 3.0000