AF 10505

MICROFILMED

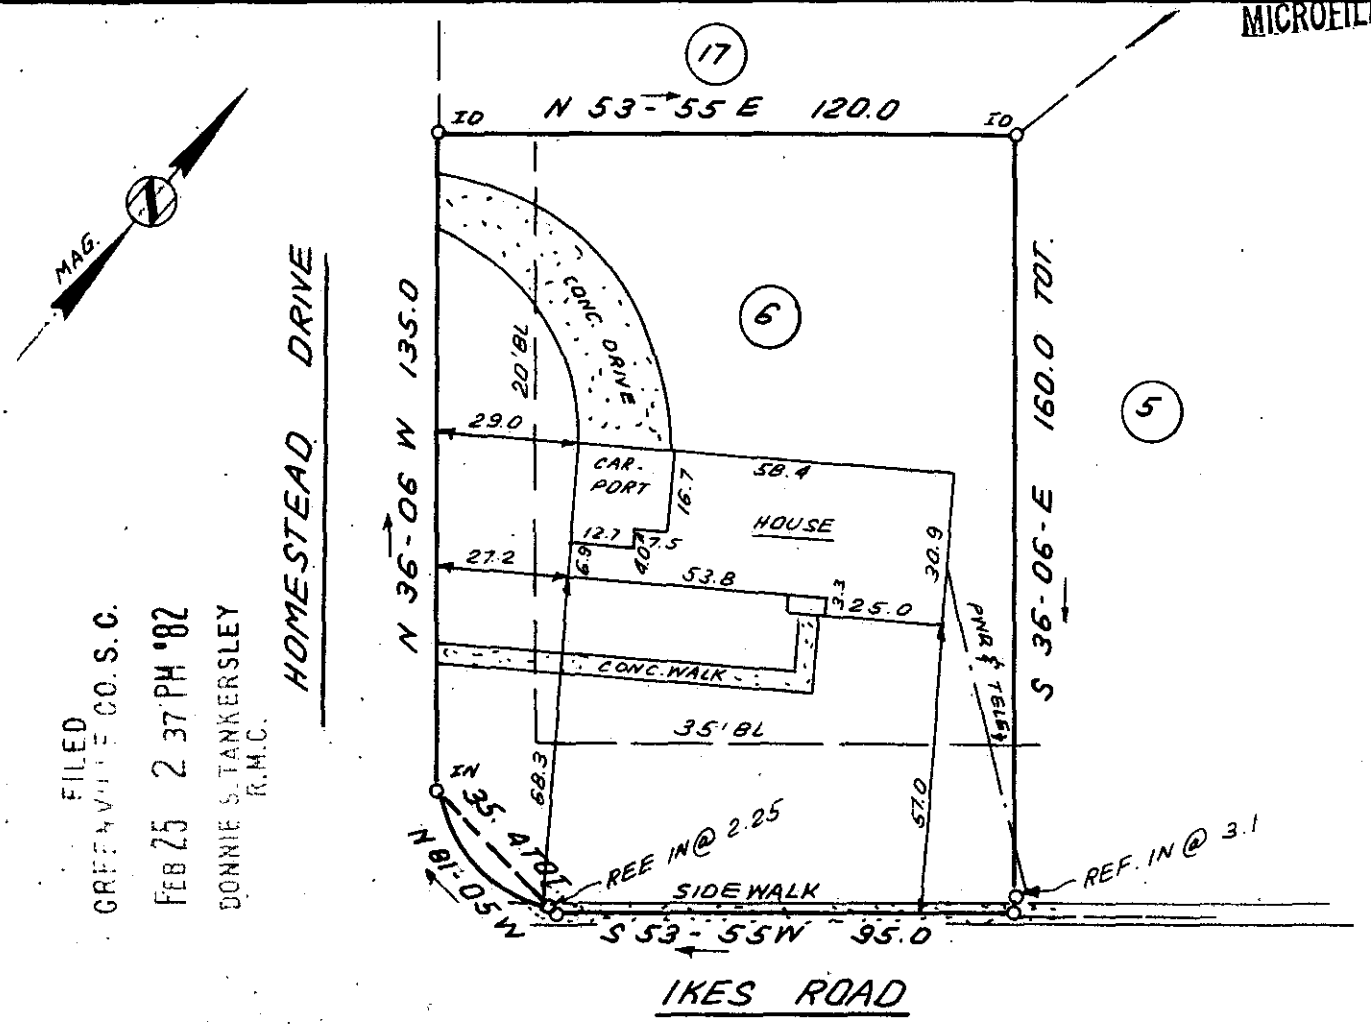

FILED
GREENVILLE CO. S. C.
FEB 25 2 37 PM '82
DONNIE S. TANKERSLEY
R.M.C.

This is to certify that on February 22, 1982, I surveyed the property shown on this plat, known as Lot 6 on plat of Homestead Acres Plat 1, recorded in the RMC Office of Greenville County in Plat Book RR on page 35, and that the property lines, walls and buildings are as shown hereon; that the building located on said lot does not encroach or project on adjacent streets or property, and that no adjacent walls or buildings encroach or project on said premises, and that no utility lines cross this property except as shown hereon. This property is not located in a designated flood hazard area.

19133

James R. Freeland
James R. Freeland RLS & PE 4781

8-Y-8

FEB 25 1982

40 0 40 80
scale feet

SOUTH CAROLINA REGISTERED LAND SURVEYOR No. 4781 JAMES RALPH FREELAND

SEAL

STATE OF SOUTH CAROLINA
GREENVILLE COUNTY

HOMESTEAD ACRES
LOT 6
PROPERTY OF
RICHARD DANIEL BUDDIN
PATRICIA GADDY BUDDIN

FREELAND & ASSOCIATES
Engineers • Land Surveyors
GREENVILLE, S.C.

SURVEY	F.E.L.
DRAWN	B.R.
CHECK	J.E. Landrith
SCALE	1" = 40'
DATE	FEB. 22. 82
DWG. NO.	7246

PRINT MACHINE INC.

CCTO ------3 FE25 82 032 3.00CD