

FILED
 GREENVILLE CO. S.C.
 MAR 12 11 23 AM '82
 DONNIE J. TANKERSLEY
 R.M.C.

This is to certify that on March 9, 1982, I surveyed the property shown on this plat, known as Pt. Lot 85 on plat of Verdin Estates, recorded in the RMC Office of Greenville County in Plat Book 6H on page 47, and that the property lines, walls and buildings are as shown hereon; that the building located on said lot does not encroach or project on adjacent streets or property, and that no adjacent walls or buildings encroach or project on said premises, and that no utility lines cross this property except as shown hereon. This property is not located in a designated flood hazard area.

5' drainage and utility easement each side of all side and rear lot lines.

20509


James R. Freeland

8-4-38

MAR 12 1982



(290.1-1-85)

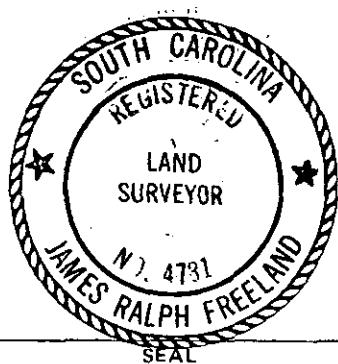

**STATE OF SOUTH CAROLINA
 GREENVILLE COUNTY**

VERDIN ESTATE
PT. LOT 85
PROPERTY OF
CHARLES DEAN WHITLOW
BECKY CHANDLER WHITLOW

FREELAND & ASSOCIATES
 Engineers • Land Surveyors

GREENVILLE, S.C.

SURVEY D.W.
DRAWN B.R.
CHECK W.B.H. III
SCALE 1" = 40'
DATE MARCH 9, 82
DWG. NO. 7285