


Note  
This lot does not lie in a level plane.

PROPERTY OF  
**DONALD R. TRAMMELL**

**MAR 12 1982**

GREENVILLE COUNTY, S. C.

and to certify that on the day of \_\_\_\_\_, 1982, I surveyed the property shown on this plat, being \_\_\_\_\_, recorded in Plat Book \_\_\_\_\_ of the R.M.C. Office for Greenville County, S. C., and that the property lines, walls and buildings are as shown hereon; that the buildings located on said lot do not encroach or project on adjacent streets or property; and that no adjacent buildings or walls encroach or project on said premises, and that no utility lines cross this property.

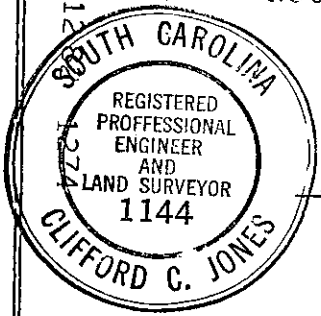

20508

MARCH - 8 - 1982



8-y-39

Jones Engineering Service 1006 E. Perry Rd.  
GREENVILLE CO. S.C.

Reg. Engineer No. 1144 S.C.

MICROFILMED