


HUNTERS TRAIL

516-59-48E

WATER & SEWER IN STRI

GREEN FILED
CO. S. C.
APR 21 3 19 PM '82
DORNING TANKERSLEY
R.M.C.

SADDLEWOOD

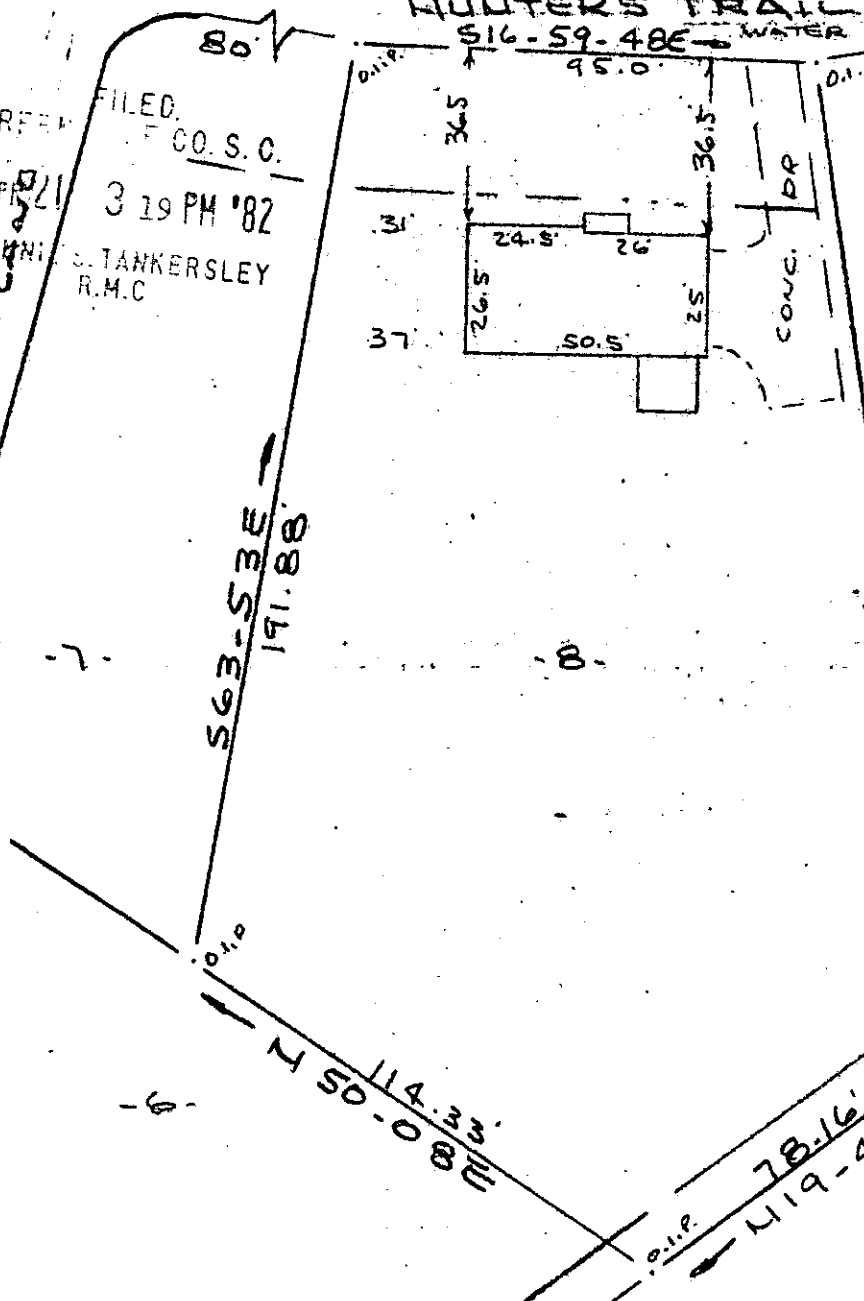

Note: Improvements on this lot are not in a flood hazard area,

Note: All lots to have 5' utility & drainage easement along side & rear lines, except as shown.

APR 21 1982

PROPERTY OF
DILIP BOAL & ANNA P. BOAL
NEAR GREENVILLE, S. C.
SCALE 1" = 40' 20 APRIL 1982



This is to certify that on the 20th day of April, 1982, I surveyed the property shown on this plat, being known as lot 8 on plat of PALMETTO DOWNS SECTION I and recorded in the REC Office Greenville County, S. C., in Plat Book "6 - H" at Page 82; and that the property lines, walls and buildings are as shown hereon, and that the walls and buildings located on said lot do not encroach or project on adjacent street or property, and that no adjacent walls or buildings encroach or project on said premises, and no power lines cross this property except as shown hereon.

23539

9-B-8

CAROLINA SURVEYING CO.
112 Manly St.
Greenville, S. C.

R. B. Brugg
R. B. Brugg, PLS 1952

GCTO --- 1AP21 82 041 3.00CI