


MICROFILMED

FILED
GREENVILLE CO. S. C.

JAMESTOWN ESTATES

MAY 11 2 18 PM '82

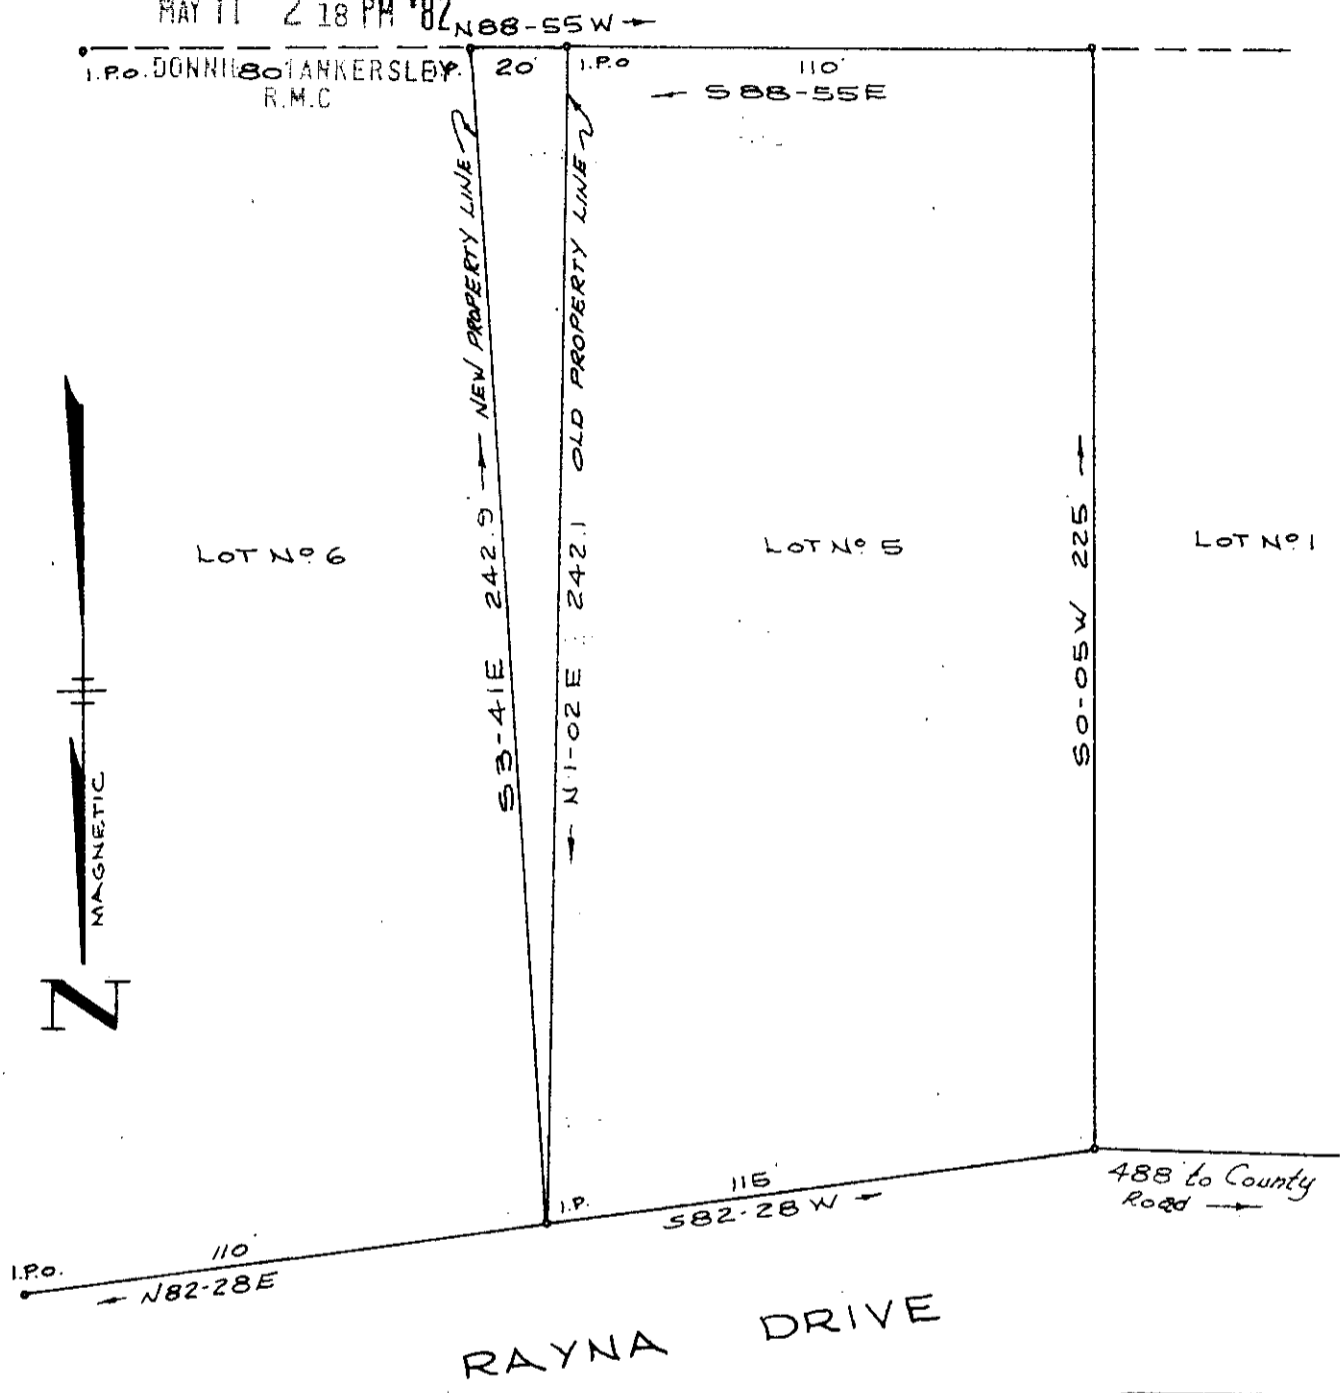


SURVEY FOR
BILLIE E. & BETTY L. HAND

LOCATED APPROX 3 MILES N.W. OF GREER
TOWNSHIP GREENVILLE, CO. S. C.

SCALE 1"=40'

APRIL 1982

APR 11 1982 413

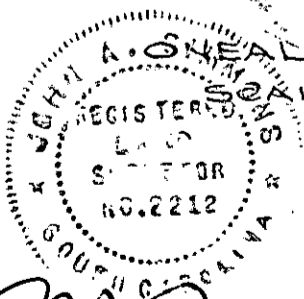

J. A. SNEAL

I HEREBY CERTIFY
THAT THE ABOVE
SURVEY IS CORRECT.

J. A. SNEAL
REG. L.S. NO 2212

25099

9-B-38

MAY 11 1982

Tri-State Surveyors
109 Few Street
Greer, S. C. 29651