


GREENVILLE CO. S.C.  
MAY 21 1982  
DONNIE WANKERSLEY

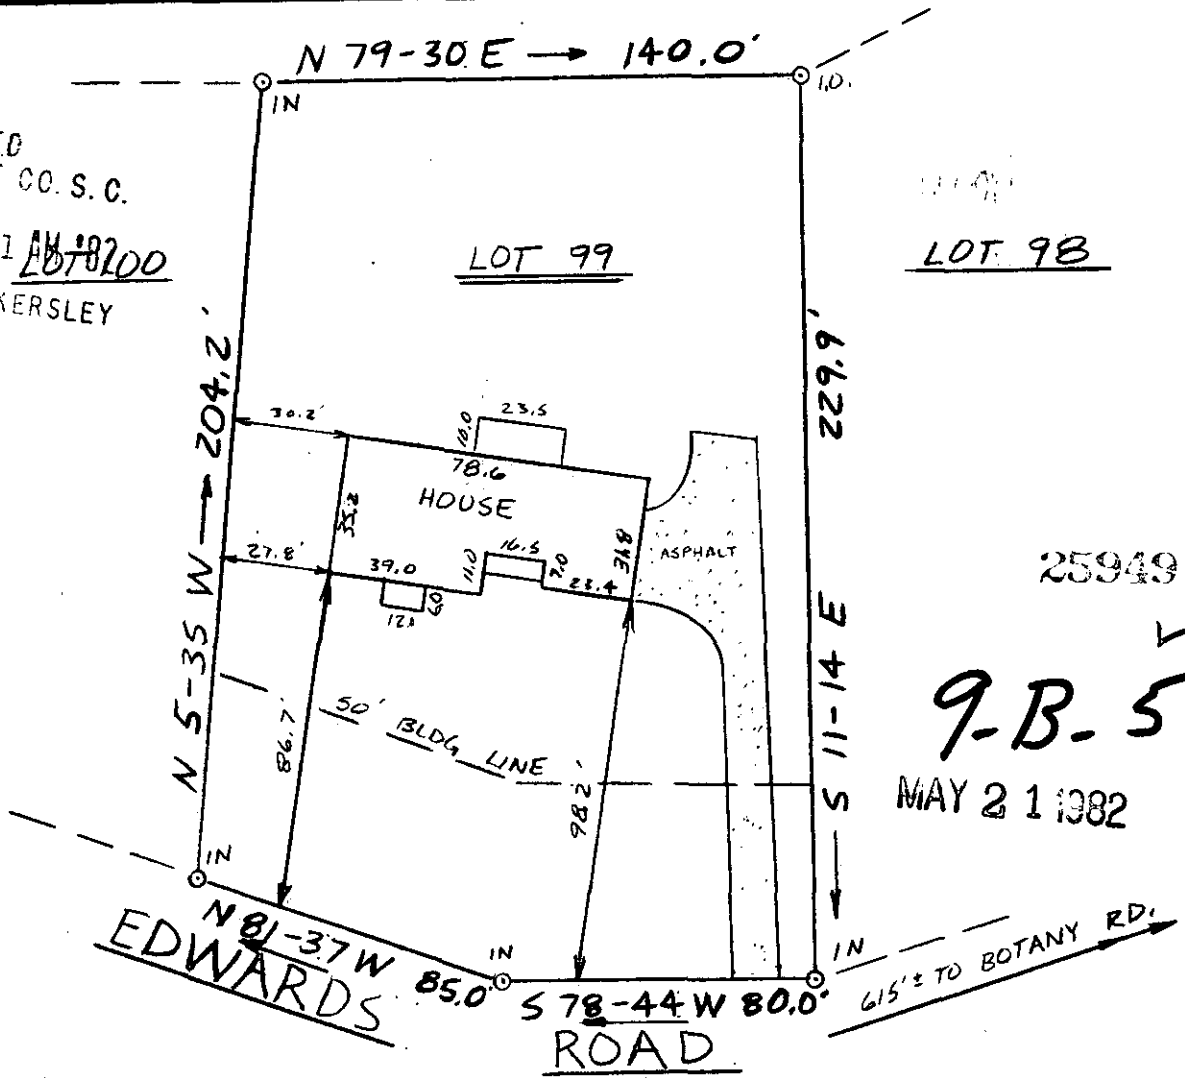

25949  
9-B-57  
MAY 21 1982

This is to certify that on September 6, 1979, I surveyed the property shown on this plat, known as Lot 99 on plat of Botany Woods, recorded in the RMC Office of Greenville County in Plat Book QQ on page 78, and that the property lines, walls and buildings are as shown hereon; that the building located on said lot does not encroach or project on adjacent streets or property, and that no adjacent walls or buildings encroach or project on said premises, and that no utility lines cross this property except as shown hereon. This property is not located in a designated flood hazard area.

10' drainage and utility easement along all side and rear lot lines.

BLK. BK. P15.13-1-100

*James R. Freeland*  
James R. Freeland RLS & PE 4781

3.00 e 36731801



SEAL

STATE OF SOUTH CAROLINA  
GREENVILLE COUNTY

BOTANY WOODS  
LOT 99-SEC. 1  
PROPERTY OF

STUART M. VAUGHAN JR.  
SARAH F. VAUGHAN

FREELAND & ASSOCIATES  
Engineers • Land Surveyors

GREENVILLE, S.C.

SURVEY	LT
DRAWN	WBH
CHECK	M.C.
SCALE	1" = 50'
DATE	9-6-79
DWG. NO.	79-4006