


FILED

GREENVILLE CO. S.C.

JUN 16 1 19 PM '82

DONNIE S. TANKERSLEY
R.M.C.

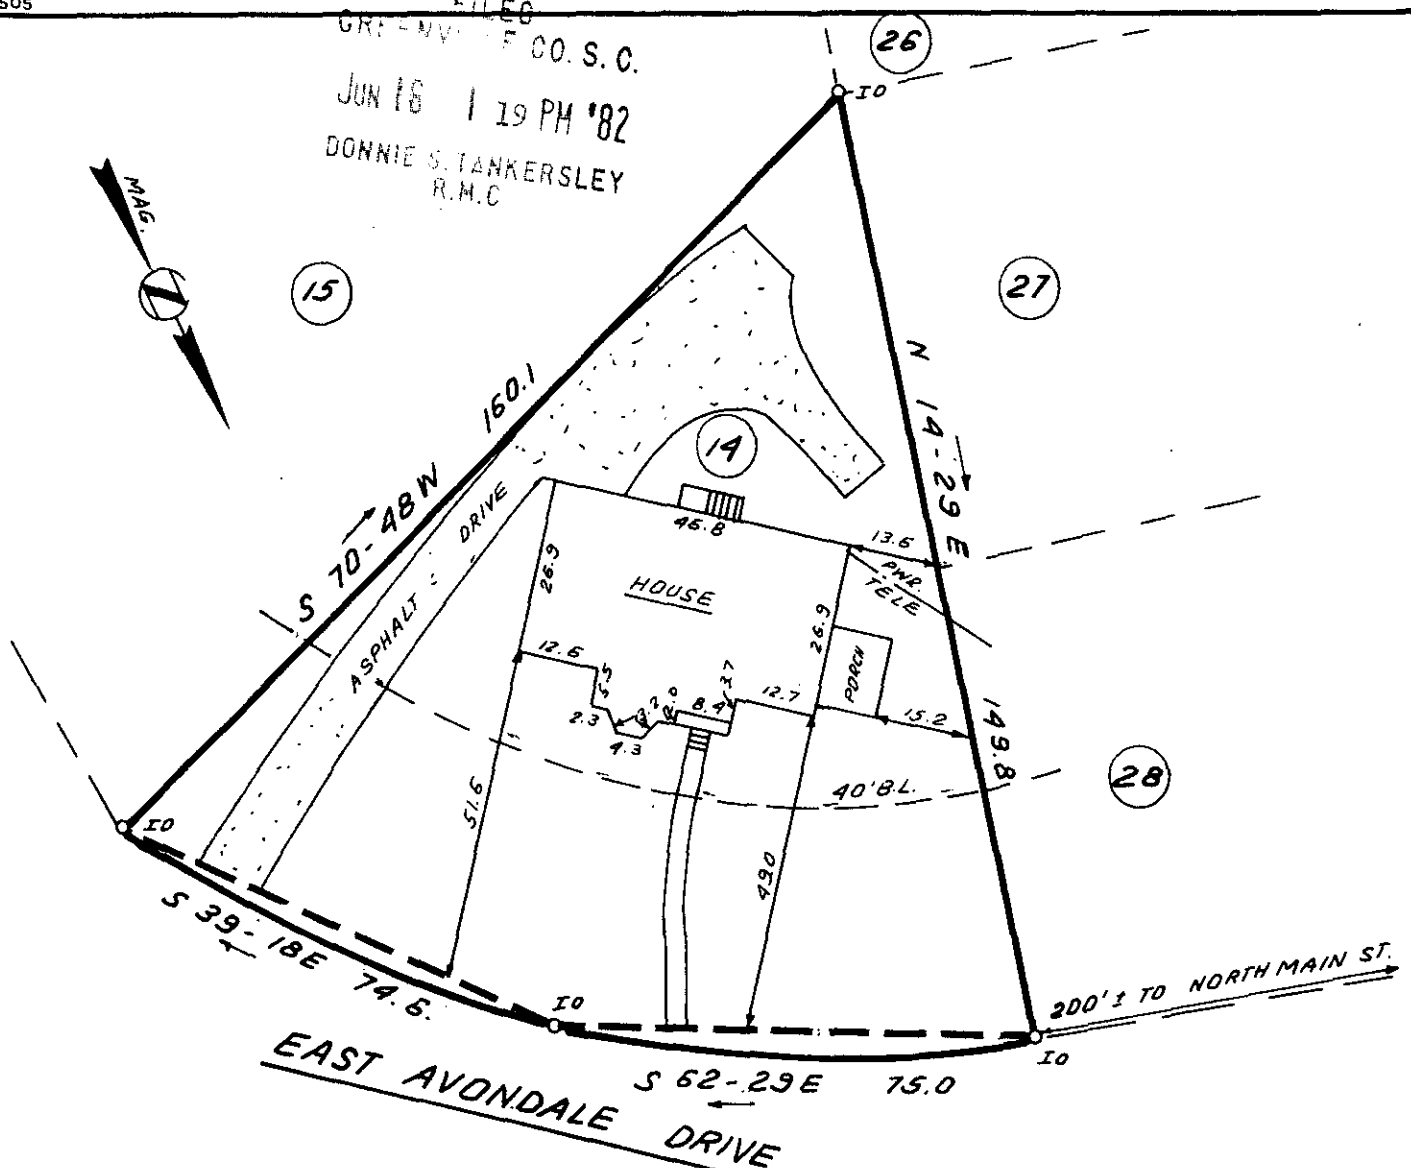

This is to certify that on June 14, 1982, I surveyed the property shown on this plat, known as Lot 14 on plat of Northgate Blk. H, recorded in the RMC Office of Greenville County in Plat Book G on pages 135 & 136, and that the property lines, walls and buildings are as shown hereon; that the building located on said lot does not encroach or project on adjacent streets or property, and that no adjacent walls or buildings encroach or project on said premises, and that no utility lines cross this property except as shown hereon. This property is not located in a designated flood hazard area.

James R. Freeland
James R. Freeland RLS & PE 4781



300 8 40261801

	<p>STATE OF SOUTH CAROLINA GREENVILLE COUNTY</p>	<p>FREELAND & ASSOCIATES Engineers • Land Surveyors</p> <p>GREENVILLE, S.C.</p>
	<p><u>NORTHGATE</u> <u>BLOCK "H"; LOT 14</u> <u>PROPERTY OF</u> <u>JOHN C. PRITCHETT</u> <u>PAMELA PRITCHETT</u></p>	<p>SURVEY <i>MLC</i></p> <p>DRAWN <i>B.R.</i></p> <p>CHECK <i>MLC</i></p> <p>SCALE 1" = 30'</p> <p>DATE <i>JUNE 14, 82</i></p> <p>DWG. NO. <i>7551</i></p>

PRINT MACHINE INC.

9-C-10 ✓

JUN 16 1982

28238