

GREENVILLE CO. S.C.


JUN 21 4 18 PM '82

DONN LANKERSLEY

CHAS. ESKEWR M.C.

WOODMONT SCHOOL ROAD

S 50-58 E 494.5

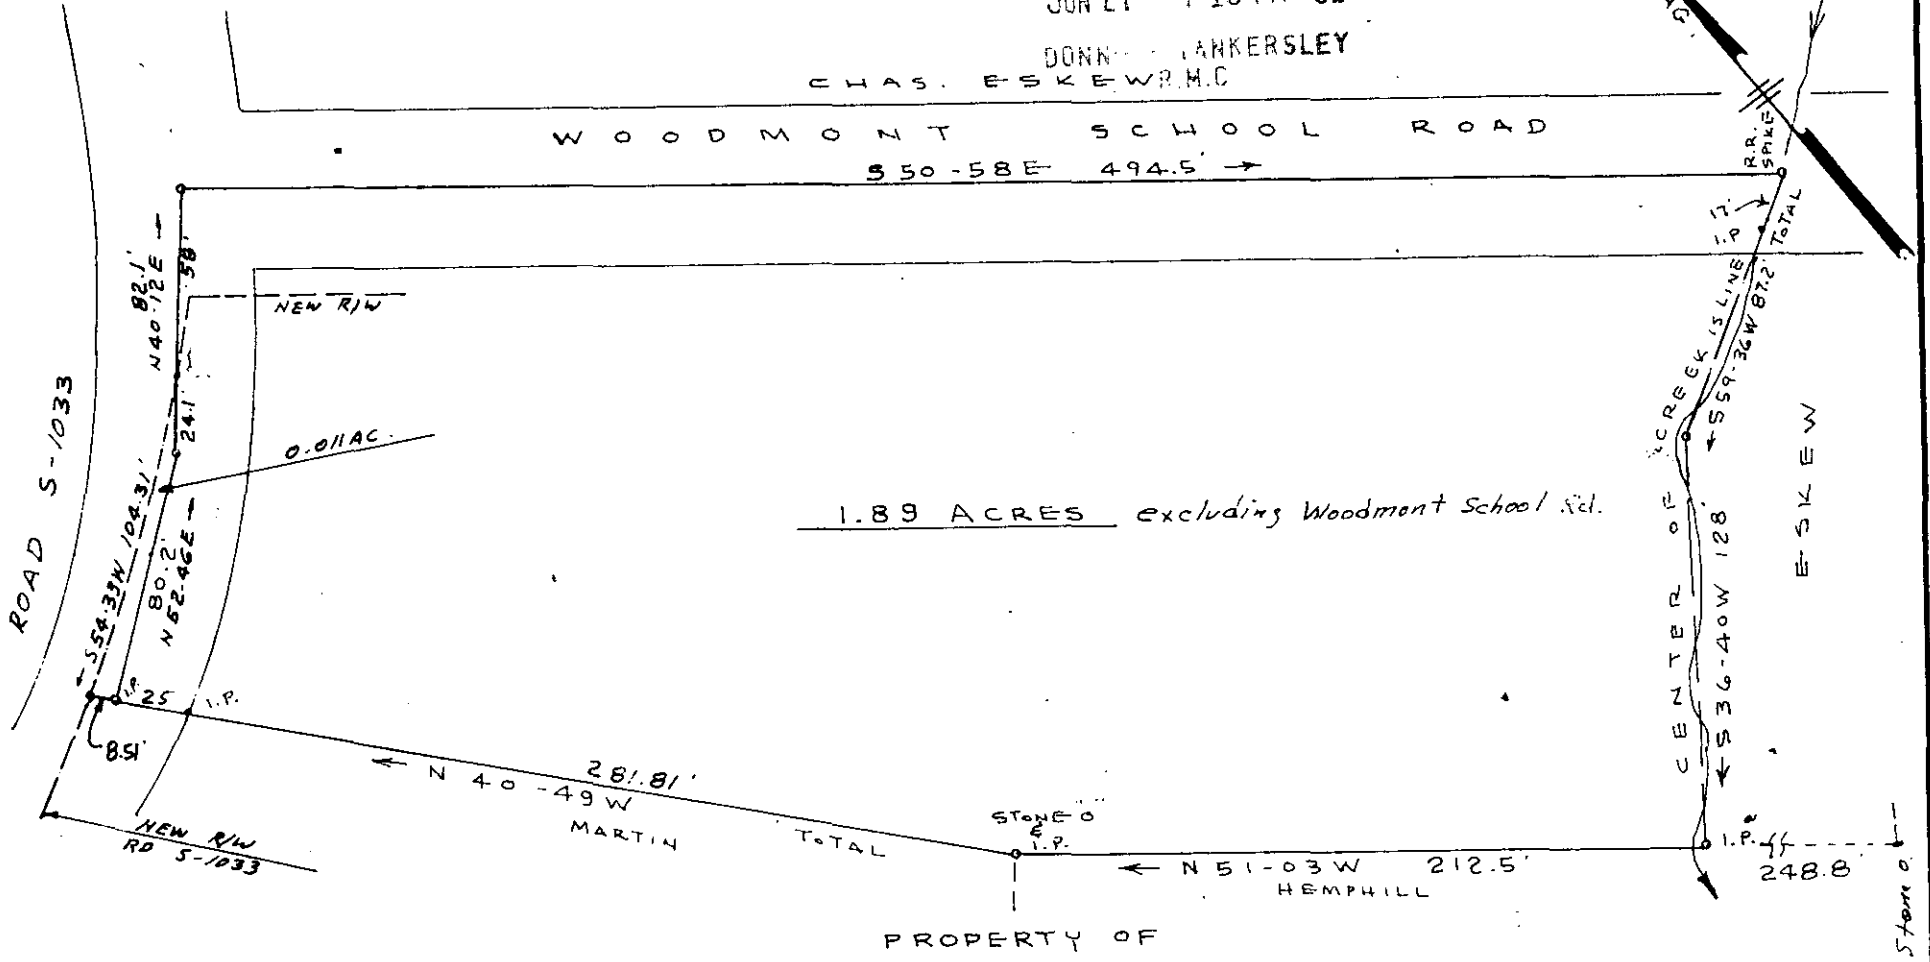

1.89 ACRES excluding Woodmont School sd.


PROPERTY OF

F. R. KINARD

GREENVILLE COUNTY S.C.

NOTE: 0.011 AC. TRACT SURVEYED  
AND ADDED TO PLAT 5/13/82  
BY C. O. RIDDLE

C. O. Riddle RIS 1347

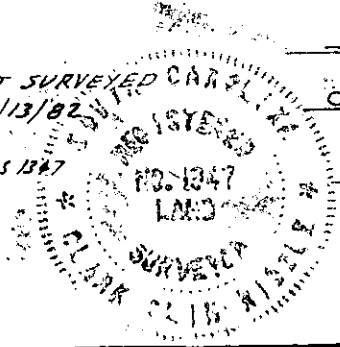

SCALE 1"=60'

NOV. 23, 1968

28657

9-C-12

ROBERT JORDAN RLS #1208

MICROFILMED