

FILED
 JUN 23 11 18 AM '82
 BONNIE STANKERSLEY
 This is to certify that on June 14, 1982, I surveyed the property shown on this plat, known as Lot 7 on plat of Augusta Court Sec. A, recorded in the RMC Office of Greenville County in Plat Book F on page 124, and that the property lines, walls and buildings are as shown hereon; that the building located on said lot does not encroach or project on adjacent streets or property, and that no adjacent walls or buildings encroach or project on said premises, and that no utility lines cross this property except as shown hereon. This property is not located in a designated flood hazard area.


James R. Freeland
 James R. Freeland RLS & PE 4781

JUN 23 1982
 28829

9-C-17



(REF. 219-1-7)

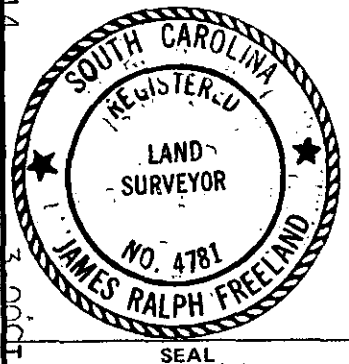

STATE OF SOUTH CAROLINA
 GREENVILLE COUNTY

AUGUSTA COURT
SECT. "A" ; LOT 7
PROPERTY OF
BOBBY H. VAUGHN

FREELAND & ASSOCIATES
 Engineers • Land Surveyors

GREENVILLE, S.C.

SURVEY	J.C.
DRAWN	B.R.
CHECK	MLC
SCALE	1" = 50'
DATE	JUNE 14, 82
DWG. NO.	7553