


FILED
GREENVILLE CO. S.C.
JUL 15 2 57 PM '82
DONNIE J. TANKERSLEY
R.M.C.

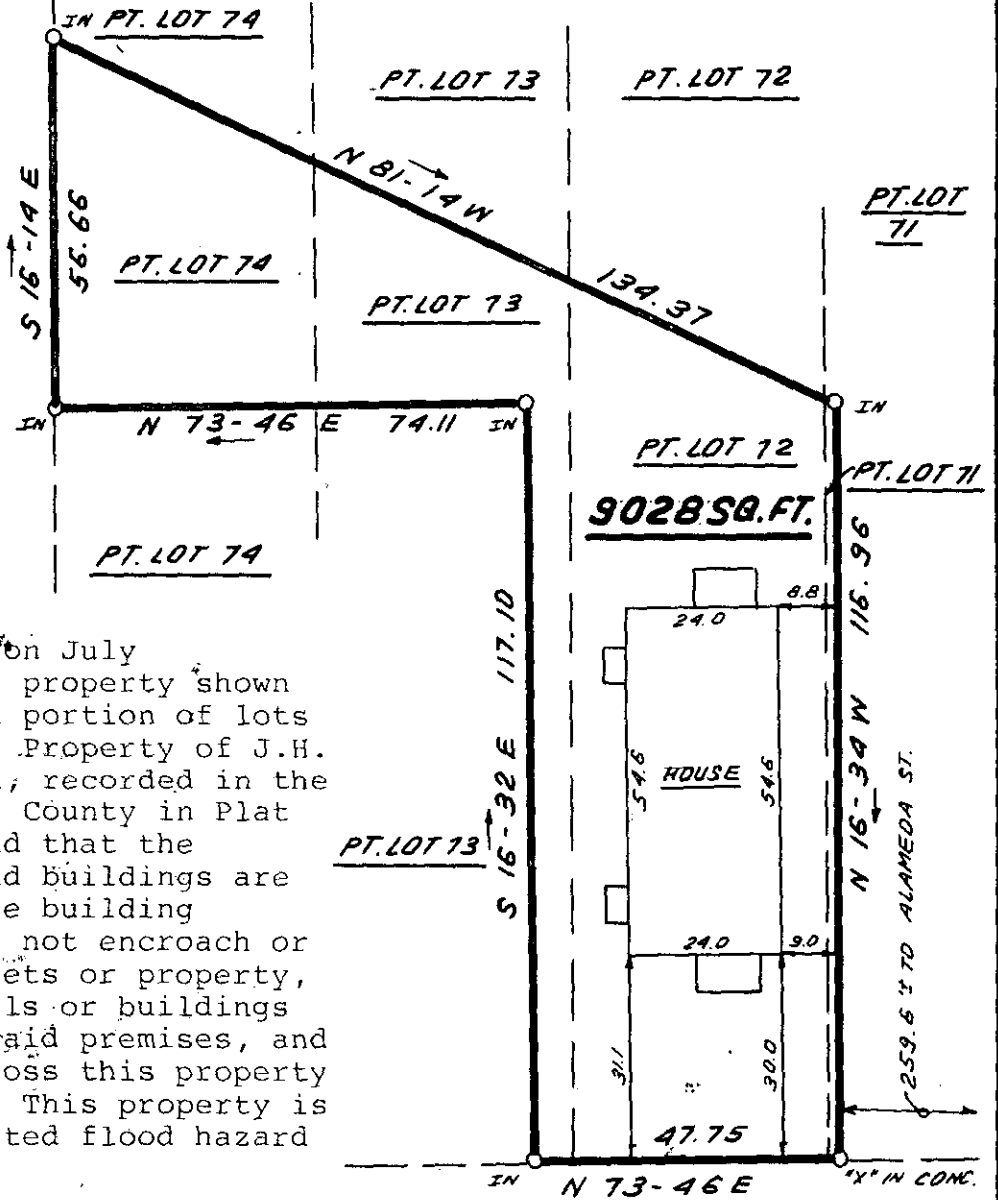

This is to certify that on July 13, 1982, I surveyed the property shown on this plat, known as a portion of lots 71, 72, 73 & 74 on plat of Property of J.H. Sitton & W.R. Crossfield, recorded in the RMC Office of Greenville County in Plat Book LLL on page 122, and that the property lines, walls and buildings are as shown hereon; that the building located on said lot does not encroach or project on adjacent streets or property, and that no adjacent walls or buildings encroach or project on said premises, and that no utility lines cross this property except as shown hereon. This property is not located in a designated flood hazard area.

James R. Freeland
James R. Freeland PLS & PE 4781

9-C-68

HILTON STREET

1191



JUL 15 1982



SEAL

**STATE OF SOUTH CAROLINA
GREENVILLE COUNTY**

**PROPERTY OF
JAMES ABBOTT WEST
CAROL W. WEST**

FREELAND & ASSOCIATES
Engineers • Land Surveyors

GREENVILLE, S.C.

SURVEY *WBH III*

DRAWN *BR*

CHECK *ML*

SCALE *1" = 30'*

DATE *JULY 13, 82*

DWG. NO. *7515-3*

300 8 42481801