


MICROFILMED

FILED  
GREENVILLE COUNTY S.C.  
JUL 30 10 55 AM '82  
DONNIE TARKERSLEY  
R.M.C.

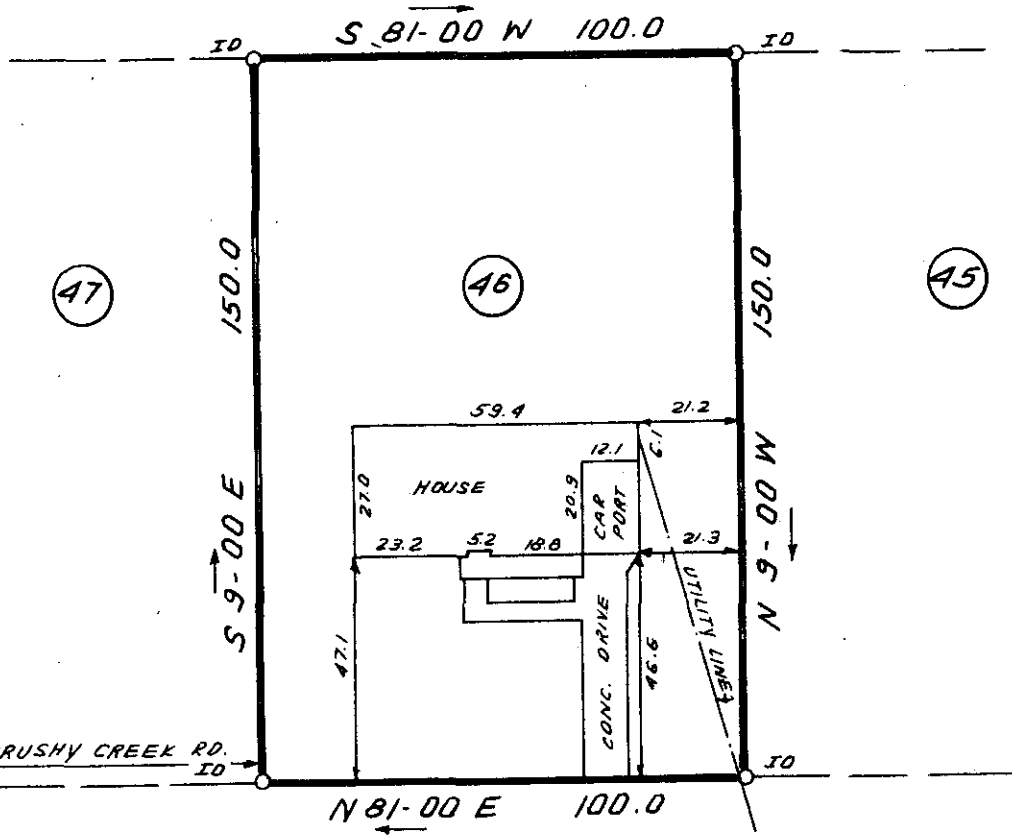

**EAST LEE ROAD**

This is to certify that on July 23, 1982, I surveyed the property shown on this plat, known as Lot 46 on plat of Colonial Hills, recorded in the RMC Office of Greenville County in Plat Book FFF on page 102, and that the property lines, walls and buildings are as shown hereon; that the building located on said lot does not encroach or project on adjacent streets or property, and that no adjacent walls or buildings encroach or project on said premises, and that no utility lines cross this property except as shown hereon. This property is not located in a designated flood hazard area.

*James R. Freeland*  
James R. Freeland PLS & PE 4781

2438



9-E-7

300 8 45411801



SEAL

**STATE OF SOUTH CAROLINA  
GREENVILLE COUNTY**

COLONIAL HILLS  
LOT 46  
PROPERTY OF  
KENNETH W. GONICK  
KATHLEEN H. GONICK

**FREELAND & ASSOCIATES**  
Engineers • Land Surveyors

GREENVILLE, S.C.

SURVEY MLC
DRAWN B.R.
CHECK <i>JRF</i>
SCALE 1" = 40'
DATE JULY 23 82
DWG. NO. 7690