MICROFILMED

Note: Improvements on this lot are not in a flood hazard area.

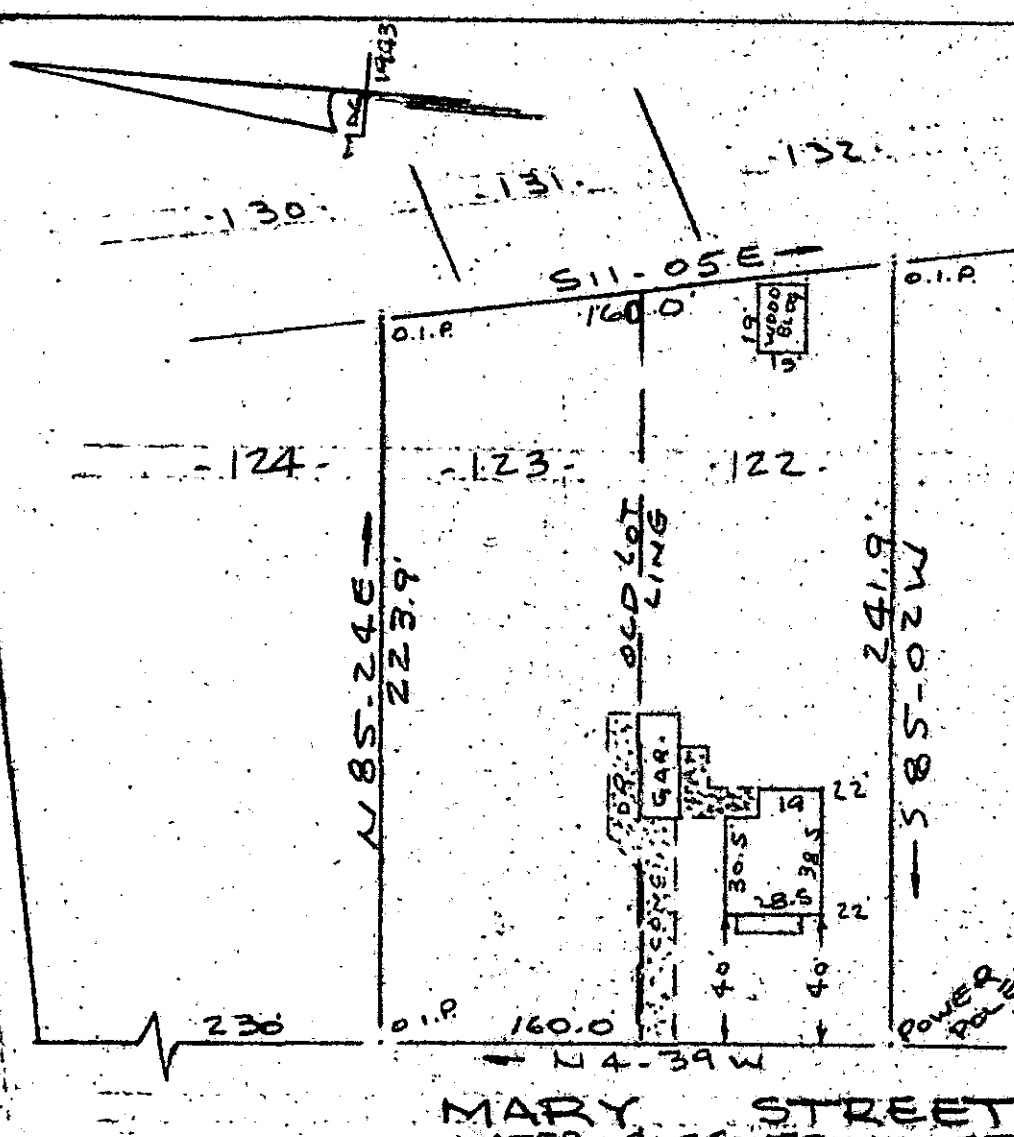

PROPERTY OF HELEN HOLLIDAY

NEAR GREENVILLE, S.C.

SCALE 1" = 40 11 AUG 1982

40 20 0 40 60

This is to certify that on the 11th day of August, 1982, I surveyed the property shown on this plat, being known as lots 122 & 123 on plat of MAP NO. 2 CAMILLA PARK and recorded in the RMC Office Greenville County, S. C., in Plat Book " M " at Page 85; and also being known as PROPERTY OF HELEN HOLLIDAY and recorded in Plat Book at Page ; and that the property lines, walls and buildings are as shown hereon, and that the walls and buildings are as shown hereon, and that the walls and buildings located on said lots do not encroach or project on adjacent street or property, and that no adjacent walls or buildings encroach or project on said premises, and no power lines cross this property except as shown hereon.

AUG 18 1982 9. E. 40 ✓

R. B. Bruce

R. B. Bruce, PLS #2032

CAROLINA SURVEYING CO.
112 Manly St.
Greenville, S. C.

4097

12 AUG 18 82 1125

3.00CI