MICROFILMED

Note: Improvements on this lot are not in a flood hazard area.

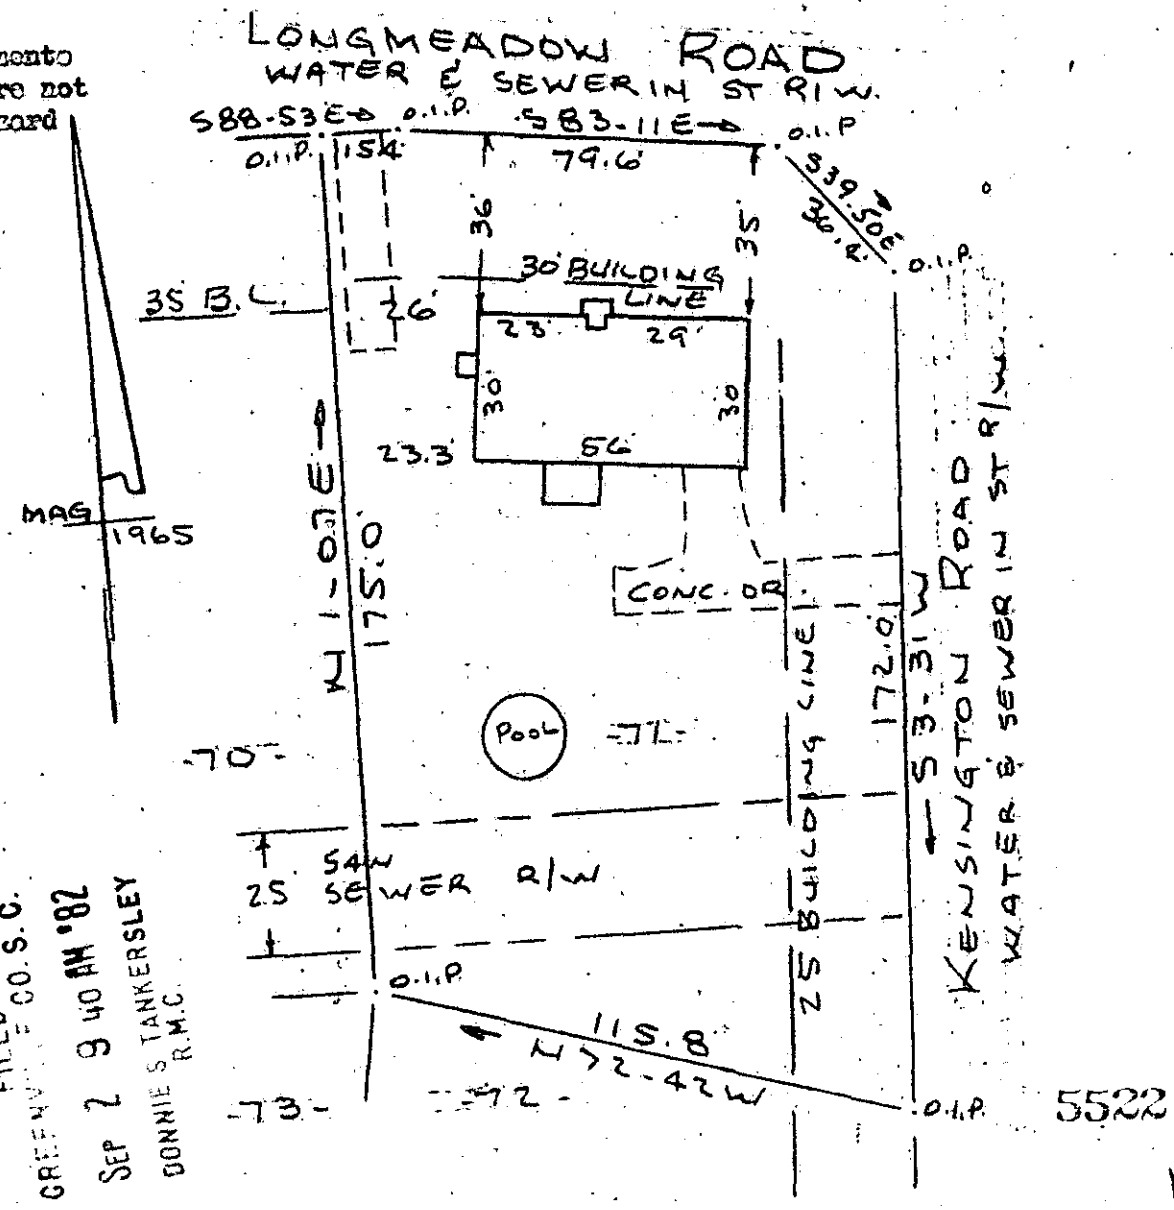

9-E-78

SEP 2 1982

PROPERTY OF
TRUMAN BROWN
NEAR GREENVILLE, S.C.
SCALE 1" = 40 25 AUG. 1982

40 20 0 40 80

This is to certify that on the 25th day of August, 1982, I surveyed the property shown on this plat, being known as lot 71 on plat of BROOKGLENN GARDENS and recorded in the RMC Office Greenville County, S. C., in Plat Book " JJJ " at Pages 84 & 85; and that the property lines, walls and buildings are as shown hereon, and that the walls and buildings located on said lot do not encroach or project on adjacent street or property, and that no adjacent walls or buildings encroach or project on said premises, and no power lines cross this property except as shown hereon.

R. B. Bruce

R. B. Bruce RLS 1952

CAROLINA SURVEYING CO.
112 Manly St.
Greenville, S. C.

2 SE 2 82
808
3.00CI