AF 10505

MICROFILMED

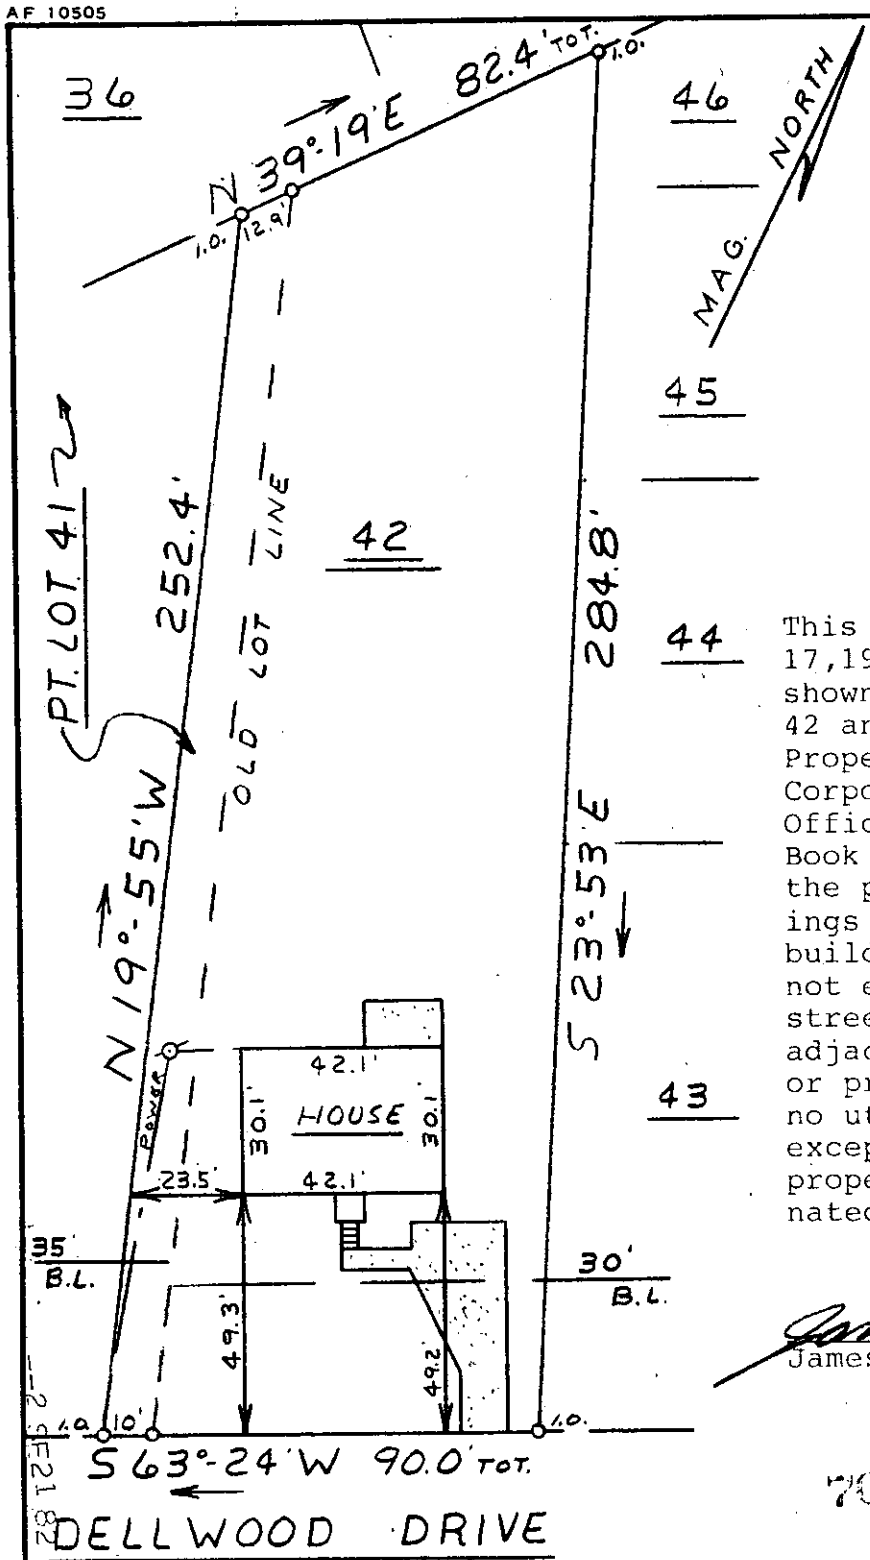

FILED
GREENVILLE CO. S. C.
SEP 21 3 53 PM '82
DONNIE S. TANKERSLEY
R.M.C

This is to certify that on September 17,1982, I surveyed the property shown on this plat, known as Lot 42 and part of Lot 41 on Plat of Property of Central Development Corporation recorded in the RMC Office of Greenville County in Plat Book BB on page 22 and 23, and that the property lines, walls and buildings are as shown hereon; that the building located on said lot does not encroach or project on adjacent streets or property, and that no adjacent walls or buildings encroach or project on said premises,and that no utility lines cross this property except as shown hereon. This property is not located in a designated flood hazard area.

James R. Freeland

James R. Freeland PLS & PE 4781

SEP 21 1982

7065 9-G-14

274.3-1-198

SOUTH CAROLINA REGISTERED LAND SURVEYOR NO. 4781 JAMES RALPH FREELAND

SEAL

STATE OF SOUTH CAROLINA
GREENVILLE COUNTY

CENTRAL DEVELOPMENT CORP.
LOT 42 & PT. 41
PROPERTY OF
HARVEY H. PRESSLEY JR. &
CHERYL S. PRESSLEY

FREELAND & ASSOCIATES
Engineers • Land Surveyors
GREENVILLE, S.C.

SURVEY	FL
DRAWN	MC
CHECK	MC
SCALE	1" = 40'
DATE	9-17-82
DWG. NO.	82-7871

PRINT MACHINE INC.