MICROFILMED

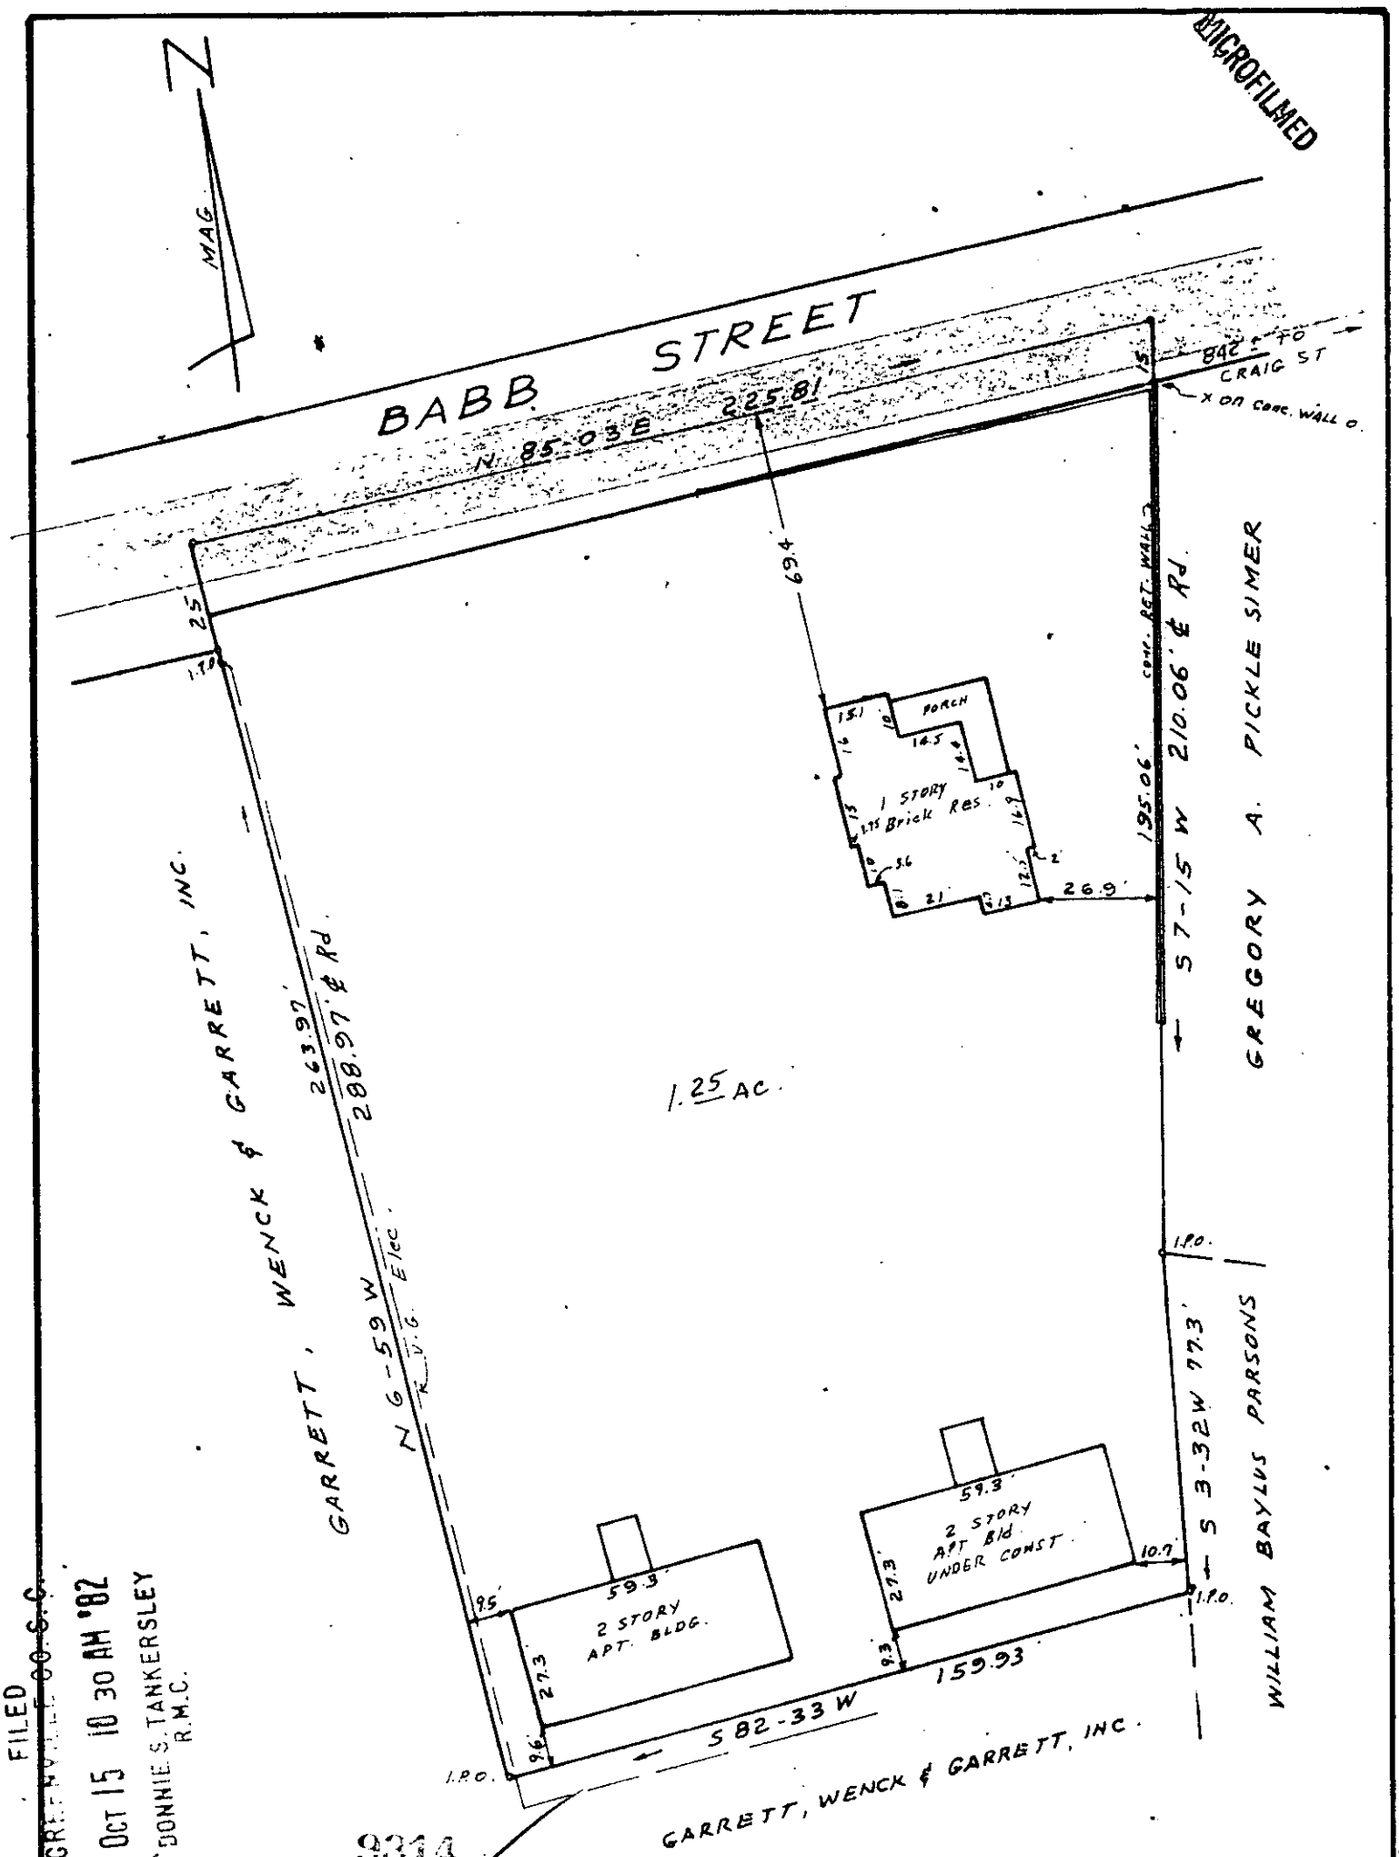

FILED
GREENVILLE CO. S.C.
OCT 15 10 30 AM '82
DONNIE S. TANKERSLEY
R.M.C.

9314

9-G-61

SURVEY FOR

ROBERT H. & LOUISE N. WILLIAMS

FOUNTAIN INN S.C.

SCALE 1" = 40' SEPT. 22, 1982

I certify that this is an accurate plat of a survey made by me September 22nd., 1982, that the structures located on said premises do not encroach or project on adjacent streets or property, that no easements are visible on the ground except as noted hereon, and that the structures located on said premises are not in a designated 100 year flood plain.

OCT 15 1982

F.B.

C. O. Riddle

RLS #1347 Greenville, S.C.

3.00 8 2961B01