

This is to certify that on October 21, 1982, I surveyed the property shown on this plat, known as Lot 1 on the plat of Sterling Annex, Block B, recorded in the RMC Office of Greenville County in Plat Book E on page 141, and that the property lines, walls and buildings are as shown hereon; that the building located on said lot does not encroach or project on adjacent streets or property, and that no adjacent walls or buildings encroach or project on said premises, and that no utility lines cross this property except as shown hereon. This property is not located in a designated flood hazard area.

James R. Freeland
James R. Freeland PLS and PE 4781


FILED
 GREENVILLE CO. S.C.
 OCT 29 3 24 PM '82
 DONNIE S. TANKERSLEY
 R.M.C.

OCT 29 1982

10419



✓
9-G-91

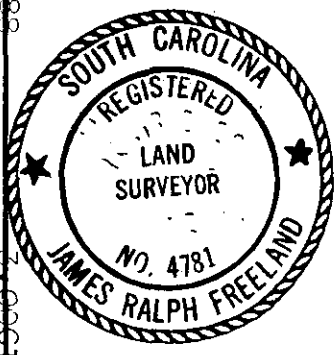

SEAL

**STATE OF SOUTH CAROLINA
GREENVILLE COUNTY**

STERLING ANNEX
BLOCK "B"; LOT 1
PROPERTY OF
JOE A. SITTON
RITA MAE DOWNS

FREELAND & ASSOCIATES
Engineers • Land Surveyors

GREENVILLE, S.C.

SURVEY L.T. & D.C.H.

DRAWN B.R.

CHECK JEF

SCALE 1" = 30'

DATE OCT. 21. 82

DWG. NO. 7966