


This is to certify that on Nov. 11, 1982, I surveyed the property shown on this plat, known as a portion of the Bob Bell Property, recorded in the RMC Office of Greenville County in Deed Book 1071 on Page 322, and that the building located on said lot does not encroach or project on adjacent streets or property, and that no adjacent walls or buildings encroach or project on said premises, and that no utility lines cross this property except as shown hereon. The dwelling is not located in a Designated Flood Hazard Area.

*James R. Freeland*  
James R. Freeland RLS & PE 4781

FILED  
GREENVILLE CO. S. C.  
NOV 16 10 10 AM '82  
BONNIE S. TANKERSLEY  
R.M.C.

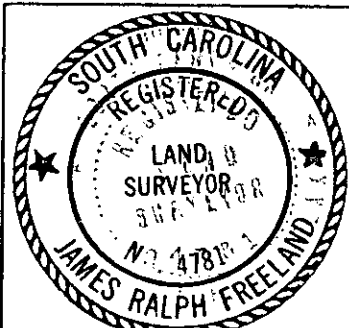

**STATE OF SOUTH CAROLINA**  
**GREENVILLE COUNTY**

PROPERTY OF  
**JAMES W. RUTH**  
**MARILYN M. RUTH**

FREELAND & ASSOCIATES Engineers • Land Surveyors	
GREENVILLE, S.C.	
SURVEY	L.T.
DRAWN	B.R.
CHECK	J.P.L.
SCALE	1" = 100'
DATE	NOV. 11. 82
DWG. NO.	8043