MICROFILMED

REF [illegible] BOOK SHT. NOS 2.05 104 & 105

NOTE
100 YEAR FLOOD LINE TAKEN FROM FLOOD PROFILES REDY RIVER TRIBUTARY 2 PLATE OR SHEET 11 P CITY OF GREENVILLE, S.C. DEPARTMENT OF HOUSING & URBAN DEVELOPMENT FEDERAL INSURANCE ADMINISTRATION

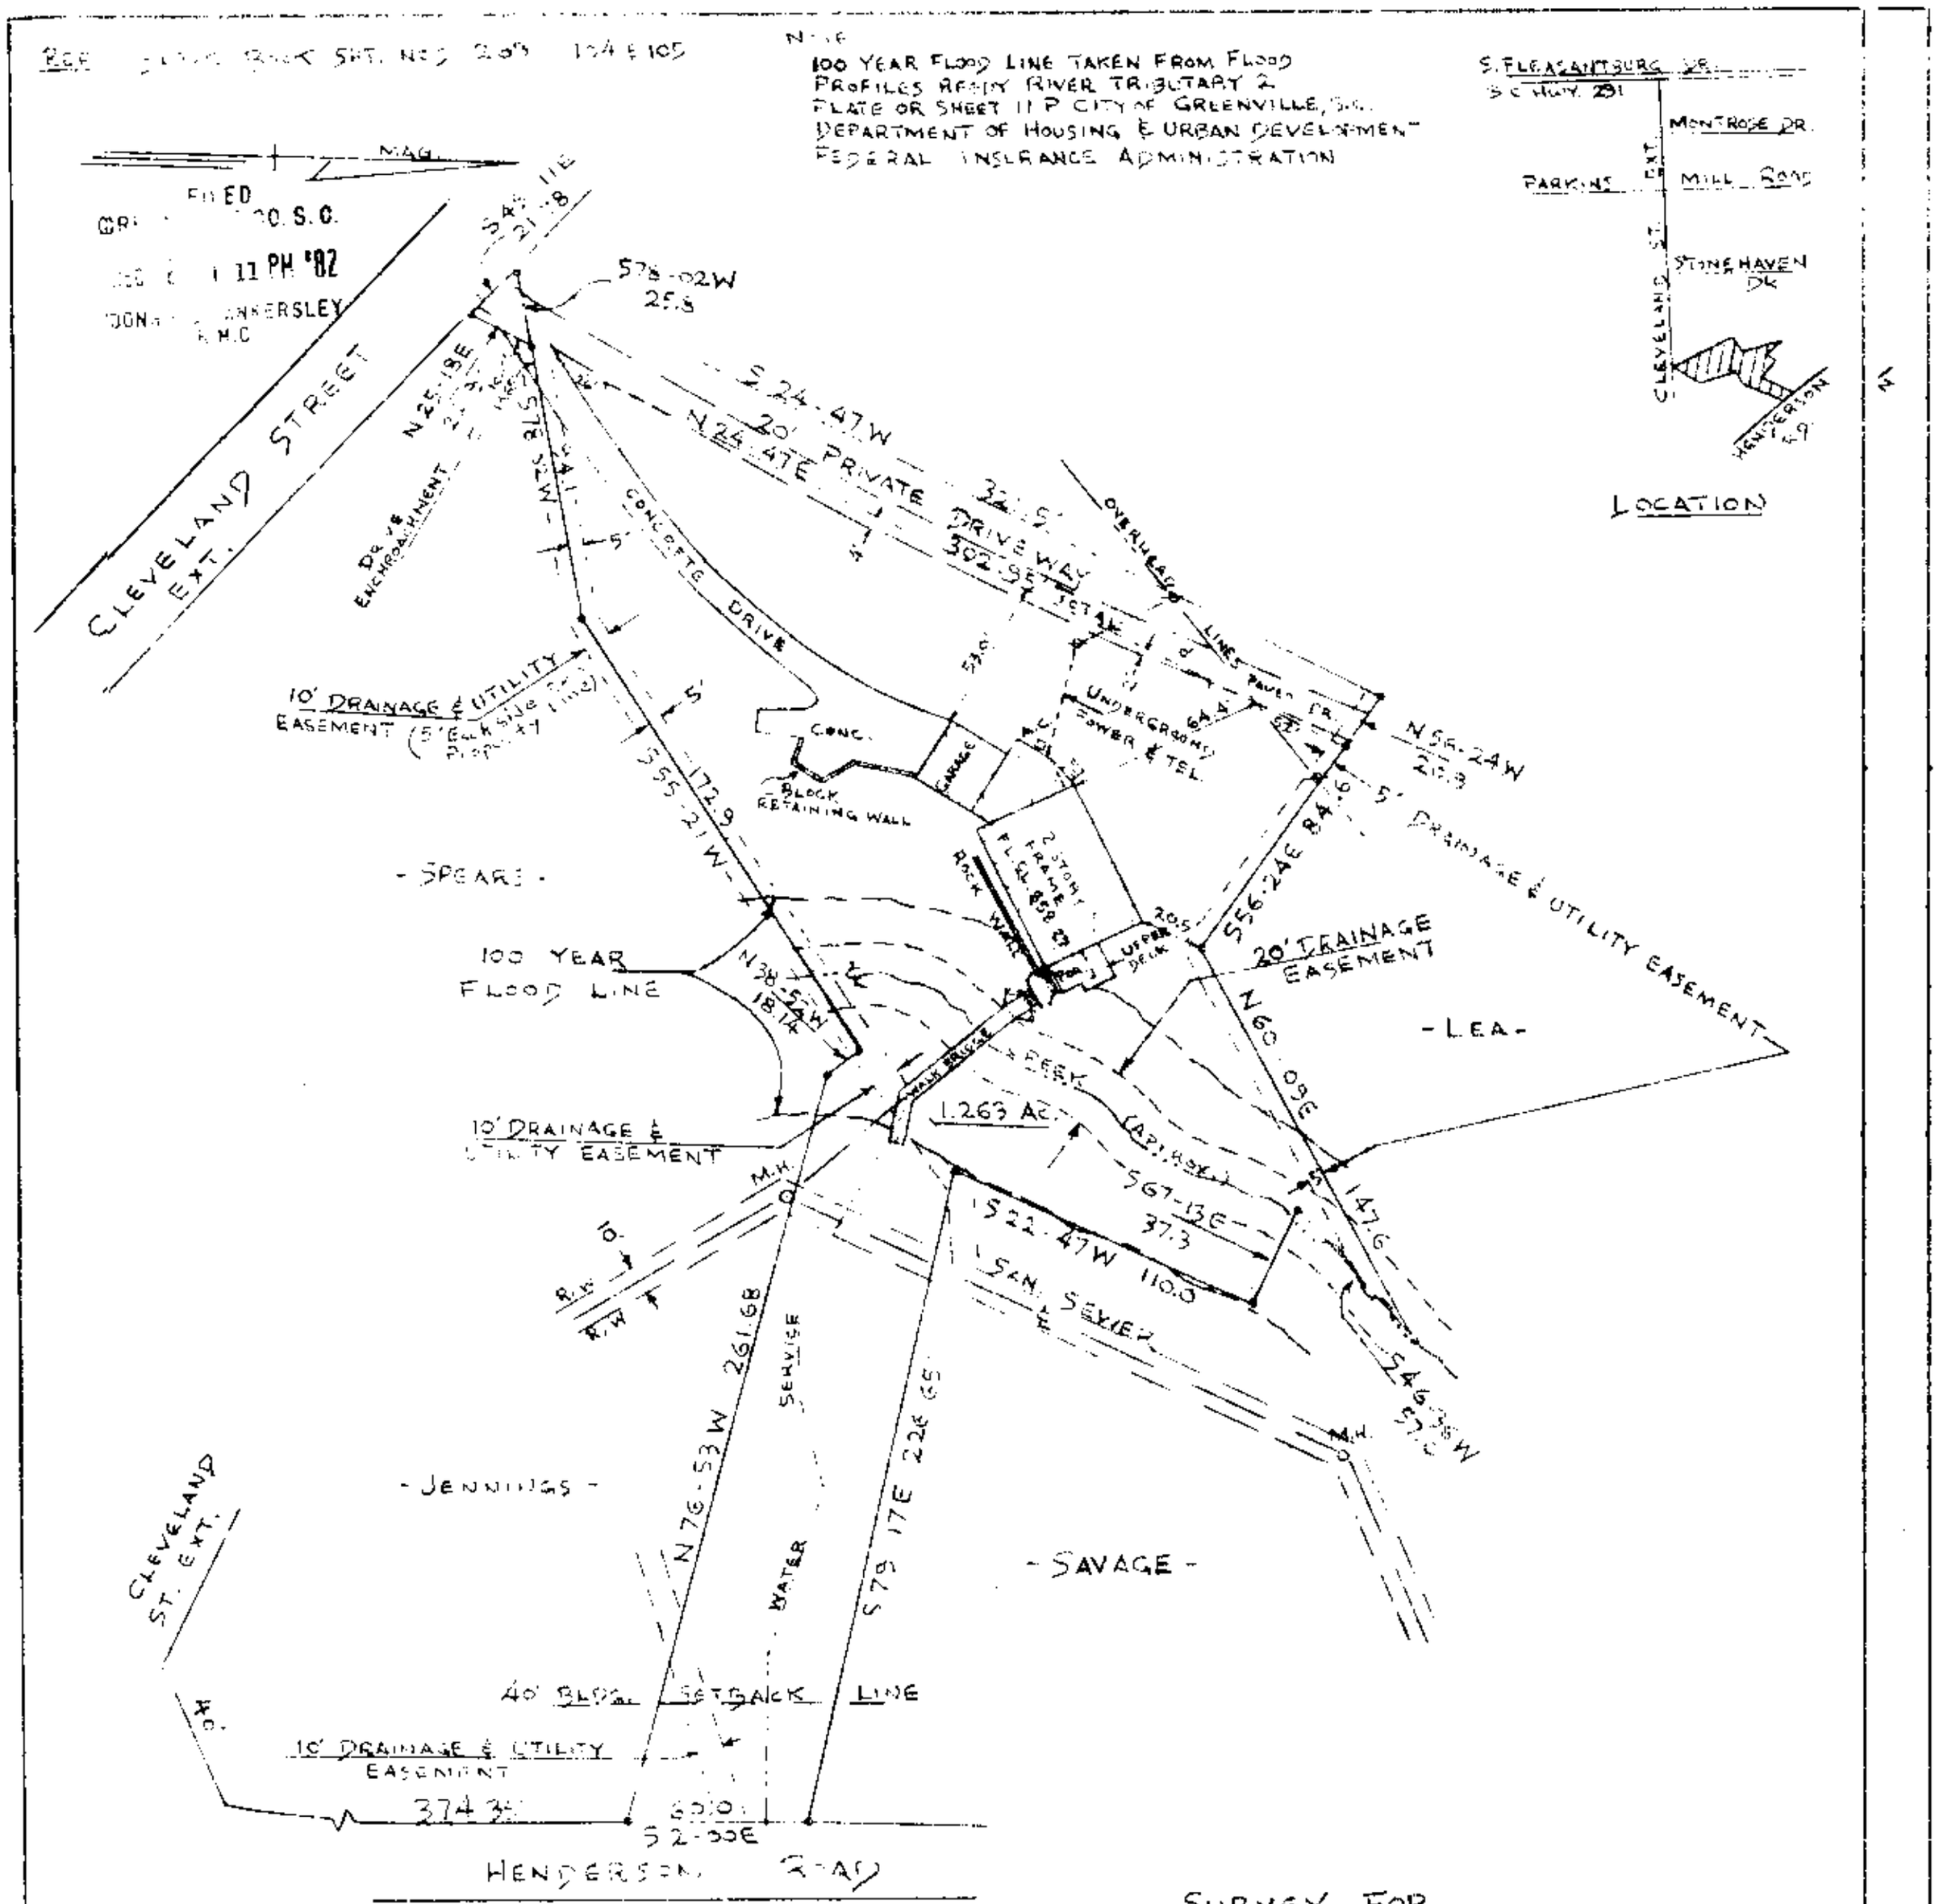

9-H-53

DEC 6 1982

13657

SURVEY FOR
MARVIN B. CROW
AND
BETTY T. CROW
GREENVILLE, S.C.
SCALE 1"=50' NOV 23, 1982

50 25 0 50 100

PIEDMONT ENGINEERS, ARCHITECTS - PLANNERS
GREENVILLE, S.C.

I HEREBY CERTIFY THAT THE MEASUREMENTS AS SHOWN ARE CORRECT AND THERE ARE NO ENCROACHMENTS OR PROJECTIONS OTHER THAN SHOWN.

RLS No 3616

[illegible] ALL CORS.