


FILED  
GREENVILLE CO., S. C.  
DEC 1 9 29 AM '82  
DONNIE S. TANKERSLEY  
R.M.C.

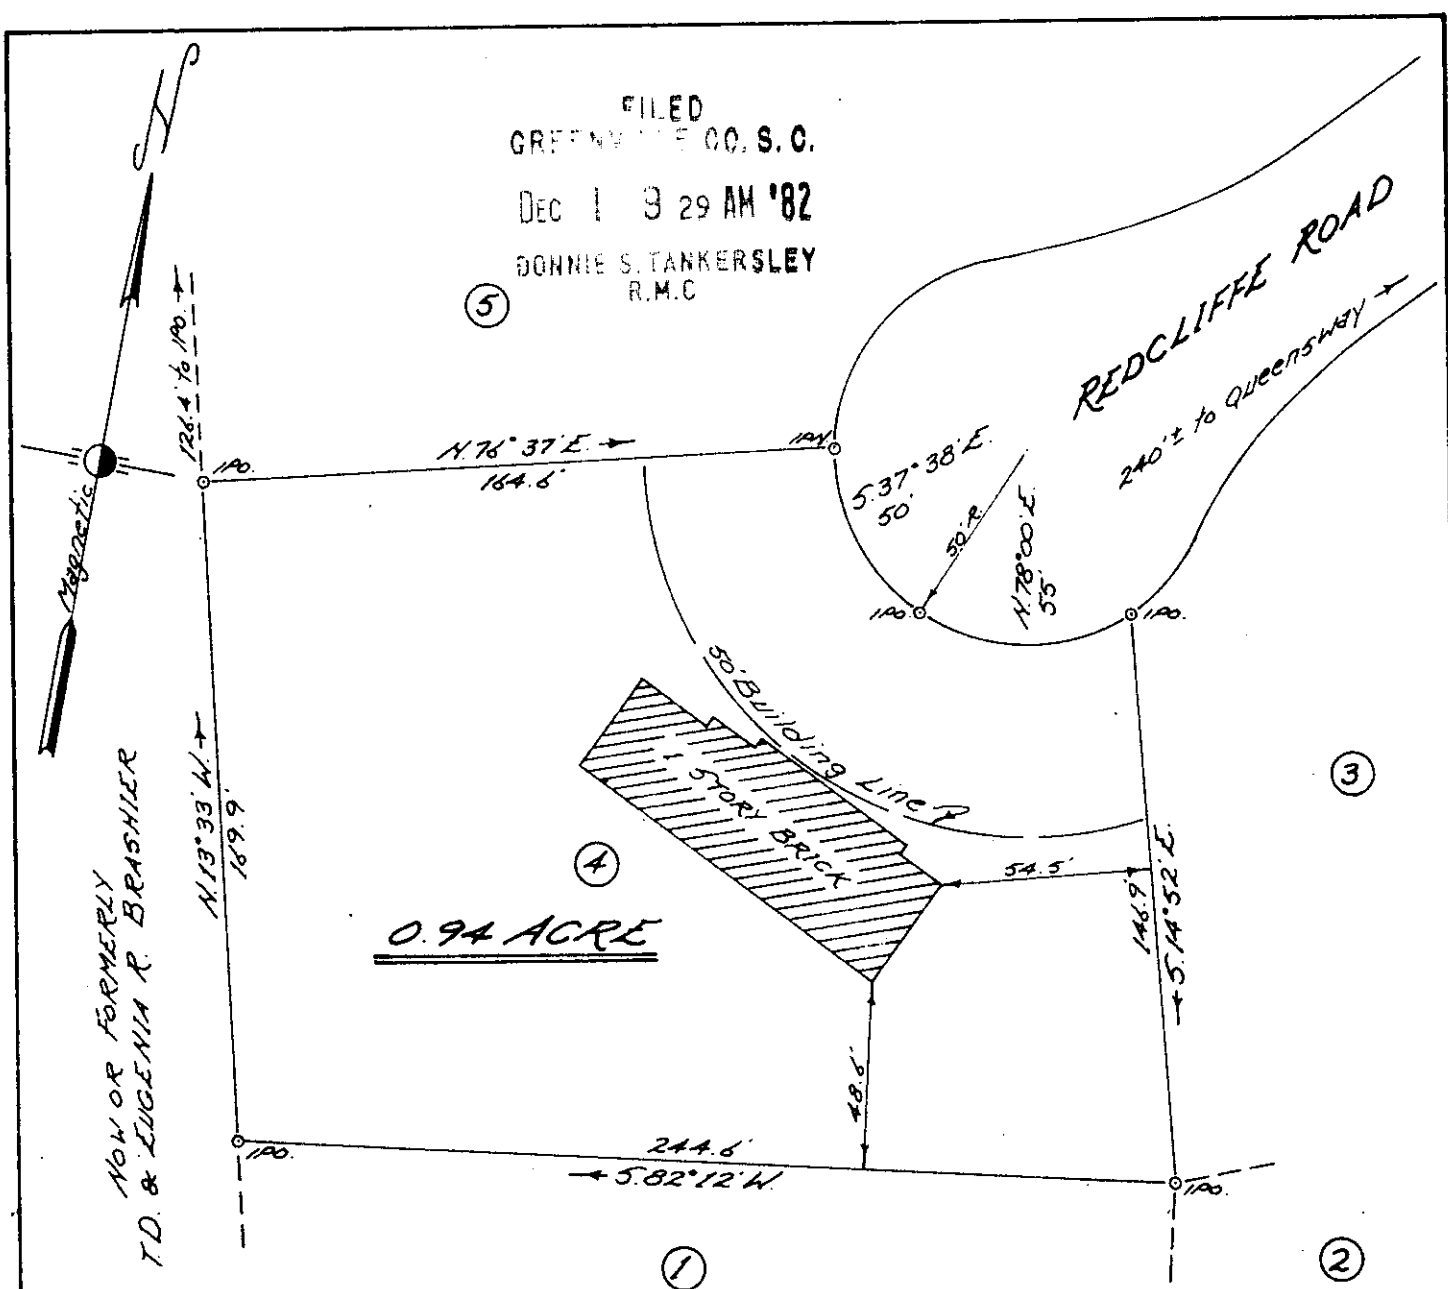

PROPERTY OF  
JAMES W. & SANDRA M. KNOX JR.

Located near Greenville

GREENVILLE COUNTY, SOUTH CAROLINA

SCALE: 1" = 50 FEET

SEPT. 28, 1982

DEC 1 1982



13292  
9-I-61 ✓

This is to certify that on Sept. 28, 1982, I surveyed the property shown on this plat, and the same is correct, being shown as Lot No. 4 on plat of Pelham Estates, Section 3, recorded in Plat Book 40 at page 13, Office of R.M.C. for Greenville County, and that the property lines, walls, and building shown thereon on said lot do not encroach or project on adjacent streets or property, and that no adjacent buildings or walls encroach or project on said premises. This property is not located in a Flood Plane.

*John H. Simmons*  
Registered Surveyor in S.C. #2212



Tri-State Surveyors  
109 Few Street  
Greer, S. C. 29651

506  
3.00CI